


Section 8 Township 24 Range 36-WWell No. #1 LoucksCompany Champlin Ref.
Hugoton Pool

NORTH

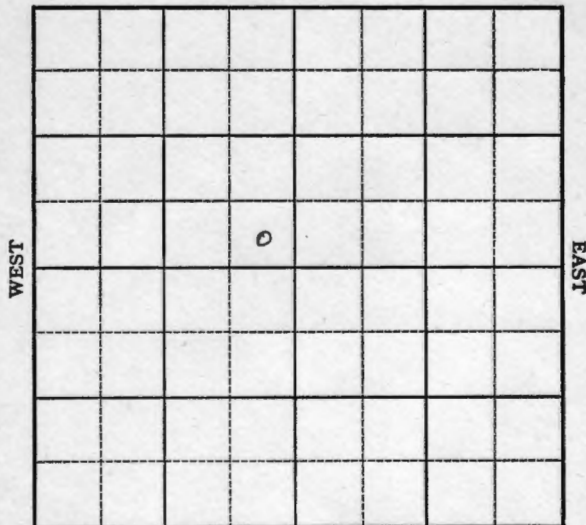

SOUTH

Kearny

KANSAS ✓

Sec. 8 Twp. 24 R. 36W

Well No. #1 Loucks Farm

Champlin Ref.

Hugoton Pool (Champlin Refg. Contr.) Company

 Ft. from N. Line

330'


 Ft. from S. Line

330'

 Ft. from E. Line

 Ft. from W. Line

SE NW

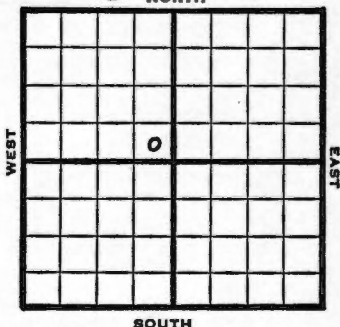

1949

Elev 3204'

REPORT

11/16

9" @ 704'

Drlg. 1795'

11/23

7" @ 2740 TD

132 shots 2704-2736 - 2500 acid

11/29

"

12/7

354 shots 2541-2654

21000 acid

12/14

"

12/21

"

12/28

"

1950

1/11

TD 2740'

9"@ 704'

7"@ 1740'

Hev 2514'

Mr 2541'

Ft Riley 2704'

17,500,000 cu ft gas

Comp

COMPLETED.

Map No. _____ Sec. 8 Twp. 24 R. 36W

Well No. 1 Loucks

Champlin Ref. _____ Company _____

Champlin Ref. _____ Contractor _____

SE NW


**FIRST REPORT
SECTION PLAT**

_____ Ft. from N. Line

330 Ft. from S. Line

330 Ft. from E. Line

_____ Ft. from W. Line

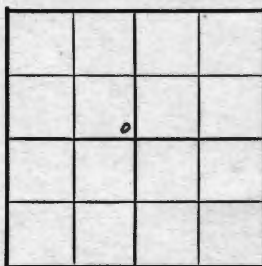

Kearny County

Location _____

Rig up _____

Drilling and Remarks:

9" @ 704

drlg. 1795

RECORD

Cased _____ in., _____ ft.

Sand _____

Gas _____

Oil _____

Total Depth _____

PRODUCTION

1st 24 hrs. Nat. _____

1st 24 hrs. after shot _____

Gas _____ Cu. Ft.

Dry Hole _____

Abandoned _____

Date

NOV 16 1949

19

S. J. LEWIS

Scout

Map No. _____ Sec. 8 Twp. 24 R. 36WWell No. 1 Loucks

_____ Champlin Ref. _____ Company

_____ Contractor


SE NW

6w 3204
SECTION PLAT

_____ Ft. from N. Line

330 Ft. from S. Line330 Ft. from E. Line

_____ Ft. from W. Line

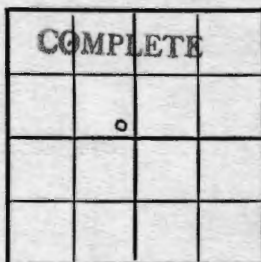

Kearny County

Location _____

Rig up _____

Drilling and Remarks:

9" @ 7047" @ 1740Ker 2514Kr 25417+ Riley 270417,500,000cu ft Gas

RECORD

Cased _____ in., _____ ft.

Sand _____

Gas _____

Oil _____

Total Depth 2740

PRODUCTION

1st 24 hrs. Nat. _____

1st 24 hrs. after shot _____

Gas _____ Cu. Ft.

Dry Hole _____

Abandoned _____

Date

JAN 11 1950₁₉J. E. TYRA Scout