


Section 2 Township 24 Range 36WWell No. #1 Barrick-LowCompany Kansas-Nebraska

NORTH

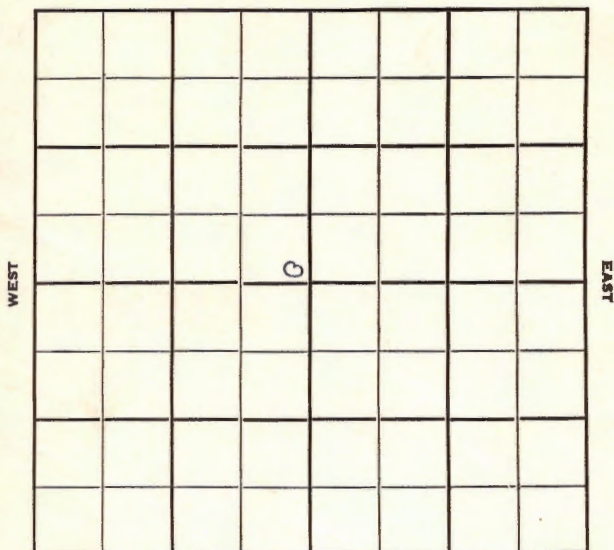

SOUTH

Kearny

KANSAS

Sec. 2 Twp. 24 R. 36W

Well No. #1 Barrick-Low Farm

Kansas-Nebraska

Company

Contractor

Ft. from N. Line

150


Ft. from S. Line

150

Ft. from E. Line

Ft. from W. Line

SE SE NW

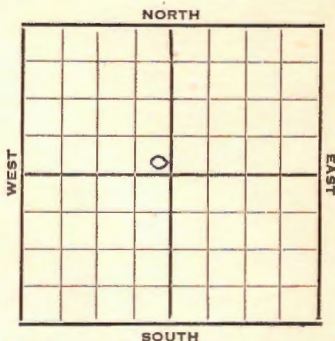

1952 **Elev. 3090'** REPORT

8/20 Spud 8-14-52
10" @ 315'
Drlg. 1900'

8/27 NR

9/3 RTD 2740 7"@ 2734

9/10 NR

9/17 "

9/24 "

10/1 "

10/8 "

10/15 "

10/22 "

10/29 **Her 2492, Krider 2512, Winfield 2548,
Up Ft. 2594', Low Ft. 2650**

96/2492-2508, 60/2512-22, 34/2548-62,
156/2594-2620, 156/2650-76 35000 tda1
A

11/5 NR

11/12 "

11/20 "

11/28 "

12/4 "

OVER

#1 Barrick-Low

1952

12/10 Spud 8-14-52

Gas Well

TD 2740'

10" @ 315'

7" @ 2734

TD 2740

Her. 2492, Kri 2512, Win 2548',

Ft. Riley 2594


96/2492-2508, 60/2512-22,


84/2548-62, 156/2594-2620

156/2650-76 35000A

Comp. 2 mcf/gpd

COMPLETED

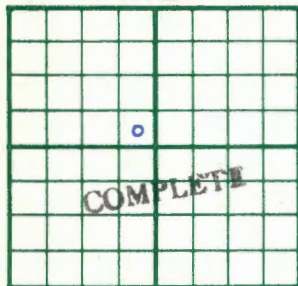County Kearny State KansasSec. 2 (Blk.) 24 (Sur.) 36W Map No.Operator Kansas-NebraskaWell No. 1 Farm Barrick-LowElev. 3090 Location SE SE NW150 Ft. From S Line NW150 Ft. From E Line Quarter1st. ReportCompletion DEC 1.0 1952RemarksSpudding Date 8-14-52Drlg. Data Gas well TD 274010" @ 315 7" @ 2734 TD 2740Her. 2492 Kri. 2512 Win. 2548Ft. Riley 2594 96/ 2492-250860/ 2512-22 84/ 2548-62 156/ 2594-2620156/ 2650-76 35000 AComp. 2 mcf/gpd

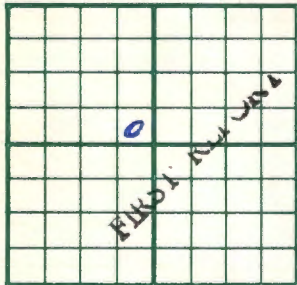County **Kearny** State **Kansas**Sec. **2** (Blk. Twp.) **24** (Sur. Rge.) **36W** Map No.Operator **Kansas - Nebraska**Well No. **1** Farm **Barrick-Low**Elev. Location **SE SE NW****150** Ft. From **S** Line **NW****150** Ft. From **E** Line **Quarter**1st. Report **AUG 20 1952**

Completion

Remarks

Spudding Date **8-14-52**

Drlg. Data

10" @ 315 Drlg. 1900**J. G. McGEHEE**