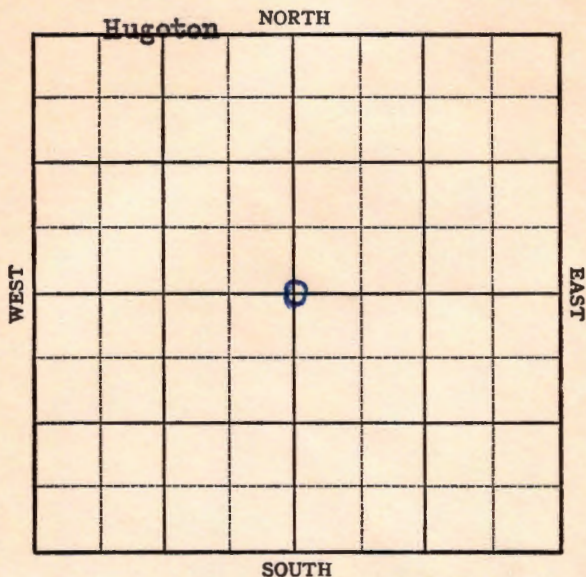


Kearny

KANSAS

Section 7 Township 24 Range 36WWell No. # 2 X LoucksCompany McMahan

KANSAS

Kearny

7

24

36W

Sec. _____ Twp. _____ R. _____

Well No. ~~#1~~ ^{#2} Loucks _____ Farm _____

McMahan

Company _____

Hugoton

NORTH


2640 Ft. from N. Line

Ft. from S. Line

2640 Ft. from E. Line

Ft. from W. Line

C Sec.

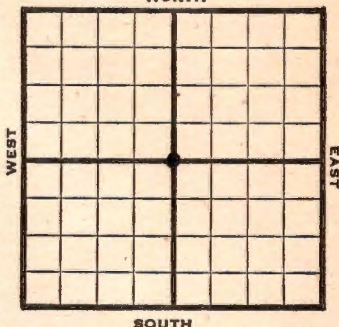

1947	Elev. 3240' REPORT
9/10	Location
9/17	13" @ 174' 10" @ 718' Drlg. 2450'
9/24	TD 2730' 7" @ 2709' RUST
10/1	TD 2743' 1000 Acid
10/8	78 shots 2678-87 - 6000 acid 132 " 2614-36 - " " 186 " 2544-85 - 5000 "
10/15	"
10/22	"
10/29	"
11/5	"
11/12	"
11/19	"
11/25	"
12/3	"
12/10	"

OVER

1947

12/30

7" @ 2709'

Perf.

23000 acid

719,000 gas da

425# R. Pr.

TD 2743'

COMPLETED

Map No. _____ Sec. 7 Twp. 24 R. 36W

Well No. 1 Loucks

McMahan Company

FIRST REPORT

Contractor

C Sec.


SECTION PLAT

2640 Ft. from N. Line

_____ Ft. from S. Line

2640 Ft. from E. Line

_____ Ft. from W. Line

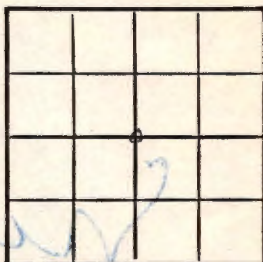

Kearny County

Location X

Rig up _____

Drilling and Remarks:

RECORD

Cased _____ in., _____ ft.

Sand _____

Gas _____

Oil _____

Total Depth _____

PRODUCTION

1st 24 hrs. Nat. _____

1st 24 hrs. after shot _____

Gas _____ Cu. Ft.

Dry Hole _____

Abandoned _____

Date

SEP 10 1947

19

S. J. LEWIS

Scout

Map No. 0 Sec. 7 Twp. 24 R. 36W

Well No. 2 Loucks

McMahan Company

CORRECTION

Contractor

C Sec.


SECTION PLAT

2640 Ft. from N. Line

_____ Ft. from S. Line

2640 Ft. from E. Line

_____ Ft. from W. Line

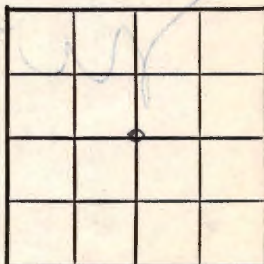

Kearny County

Location _____

Rig up _____

Drilling and Remarks:

Reported

#1 Loucks

RECORD

Cased _____ in., _____ ft.

Sand _____

Gas _____

Oil _____

Total Depth _____

PRODUCTION

1st 24 hrs. Nat. _____

1st 24 hrs. after shot _____

Gas _____ Cu. Ft.

Dry Hole _____

Abandoned _____

Date

SEP 17 1947 19

S. J. LEWIS

Scout

