


Kearny

KANSAS

Section 13 Township 24 Range 36WWell No. #1 Thorpe (A)Company Stanolind

NORTH

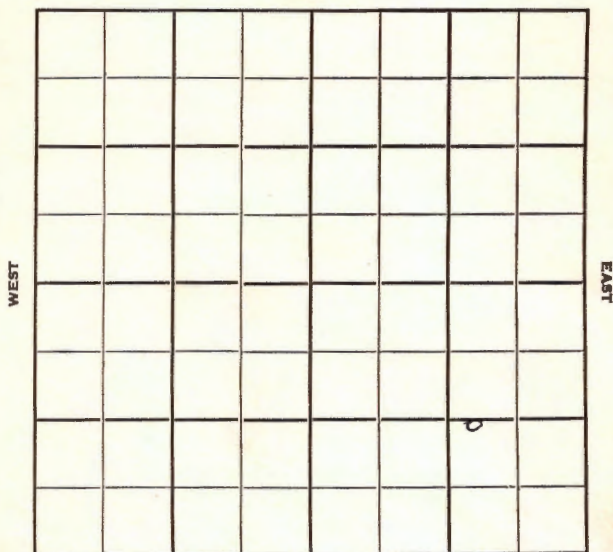

SOUTH

KANSAS

Kearny

Sec. 13 Twp. 24 R. 36W

Well No. #1 Thorpe (A) Farm

Stanolind Company

Contractor

Hugoton Pool


Ft. from N. Line

1250' Ft. from S. Line

1000' Ft. from E. Line

Ft. from W. Line

C WL E $\frac{1}{2}$ SE

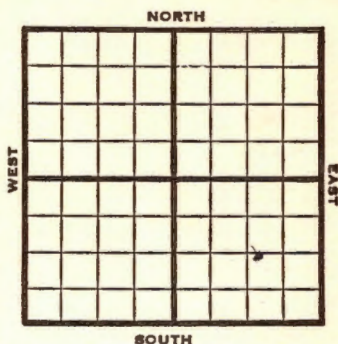

1951

Elev. 3014' REPORT

6/13
8/8

Location

Spud 7-18-51

Gas well TD 2635' 10" @ 805'

Her. 2409' Win 2472' Ft. Riley


2532' 6" @ 2587' TD 2635'

222/2528-65 60/2474-84

192/2405-37 19,500 A

Comp. 9,977,000 gas 395#

COMPLETED

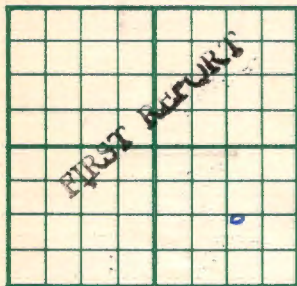County **Kearny** State **Kansas**Sec. **13** (Blk. Twp.) **24** (Sur. Rge.) **36W** Map No.Operator **Stanolind**Well No. **1** Farm **Thorpe (A)**Elev. Location **CWL B₂ SE****1250** Ft. From **S** Line **SE****1000** Ft. From **S** Line Quarter1st. Report **JUN 13 1951**

Completion

Remarks

Spudding Date

Drig. Data

Location **Hugoton Pool**

J. E. TYRA

County Kearny State KansasSec. 13 (Blk.
Twp.) 24 (Sur.
Rge.) 36W Map No.Operator StanolindWell No. 1 Farm Thorpe "A"Elev. 3014 Location C W L E $\frac{1}{2}$ SE1250 Ft. From S Line SE1000 Ft. From E Line Quarter

1st. Report

Completion AUG 8 1951Remarks Hugoton PoolSpudding Date 7-18-51Drlg. Data Gas well TD 263510" @ 805 Her. 2409 Win. 2472Ft. Riley 2532 6" @ 2587 TD 2635222/ 2528-65 60/ 2474-84 192/ 2405-3719500 A Comp. 9,977,000 gas 395#