


Section 15 Township 24 Range 36 W

Well No. # 1 Abolt Gas Unit

Company Stanolind

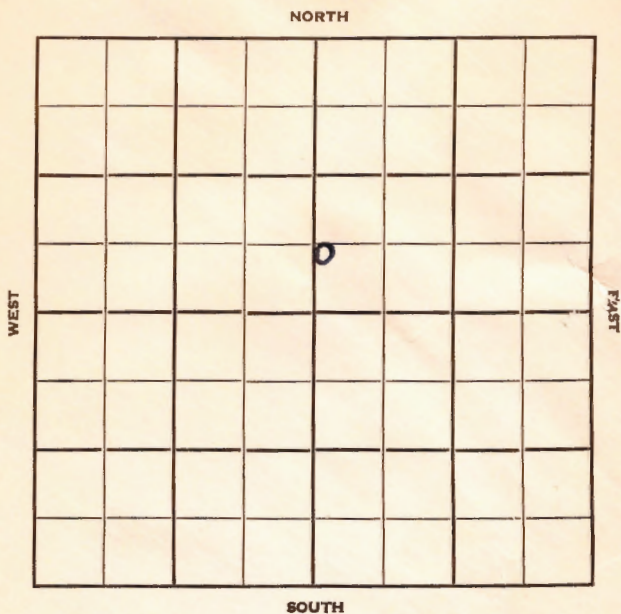

Sec. 15 Twp. 24 R. 36 W

Well No. # 1 Abolt Gas Unit Farm

Stanolind Company

Contractor

Ft. from N. Line

550


Ft. from S. Line

Ft. from E. Line

150

Ft. from W. Line

App C W/2 SW NE

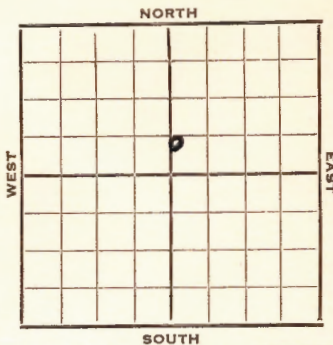

Elev. 3057 LS

Elev. 3054' XLGR REPORT

1952

9/17

Location

9/24

8" @ 683
Drlg. 2168

10/1

Her. 2421 Winfield **2480**
Ft Riley 2591
RTD 2609' **5" @ 2591' CO**

10/8

Spud 9-16-52
Gas well TD 2616' 8" @ 683 **Her 2421'**
Win. 2480' Ft. Riley 2591'
TD 2609' 5" @ 2591 DD 2616'
2400 A 42/2422-29 42/2433-40
36/2444-50 42/2460-67 12/2480-82
54/2484-93 60/2502-12 36/2522-28
24/2538-42 30/2546-61 30/2566-71
27,500 A
Comp. 8,895,000 gas

COMPLETED

County **Kearny** State **Kansas**

Sec. **15** (Blk. Twp.) **24** (Sur. Rge.) **36W** Map No.

Operator **Stanolind**

Well No. **1** Farm **Abolt Gas Unit**

Elev. **3054 GL** Location **App C W/2 SW NE**

| | | | | | |
|--|--|--|--|--|--|
| | | | | | |
| | | | | | |
550 Ft. From **S** Line **NE**

150 Ft. From **W** Line Quarter

1st. Report **SEP 17 1952**

Completion

Remarks

Spudding Date

FIRST REPORT

Drig. Data

Location

J. G. McGEHEE

