


KANSAS

Section 16 Township 24 Range 36W

Well No. #1 McDowell

Company Kansas-Nebraska

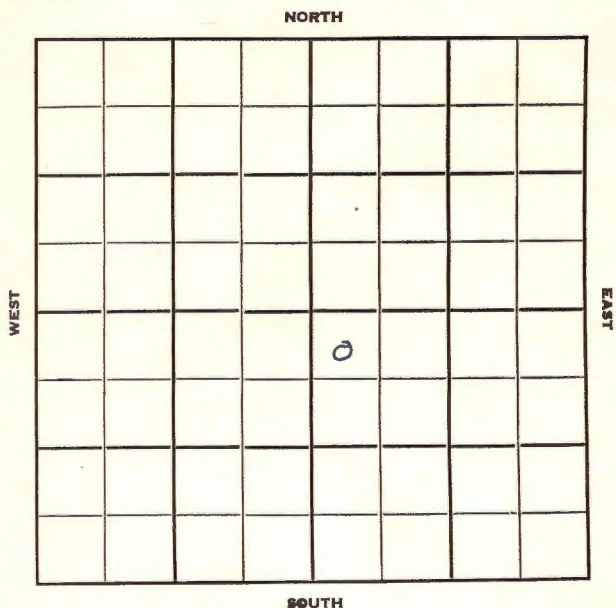

Kearny

KANSAS

Sec. 16 Twp. 24 R. 36W

Well No. #1 McDowell Farm

Kansas - Nebraska

Company

Contractor

Hugoton


200' Ft. from N. Line

Ft. from S. Line

Ft. from E. Line

300' Ft. from W. Line

NW NW SE

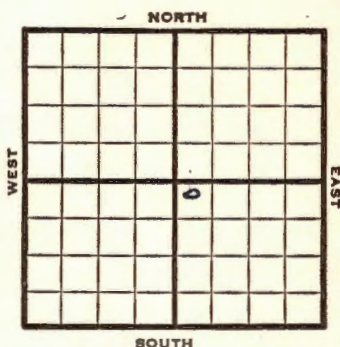

1951

Elev. 3089'

REPORT

11/14

Location

1952

2/6

TD 2651 7" @ 2645
50,000 A

2/13

Spud 12-13-51

Gas Well TD 2651

10" @ 360 7" @ 2645

TD 2651

108/2424-40 72/2444-56

96/2480-96 84/2548-62

168/2584-2614 50,000 A

Her. 2416 Kri 2443

Comp. 26,000,000 gas

COMPLETED

