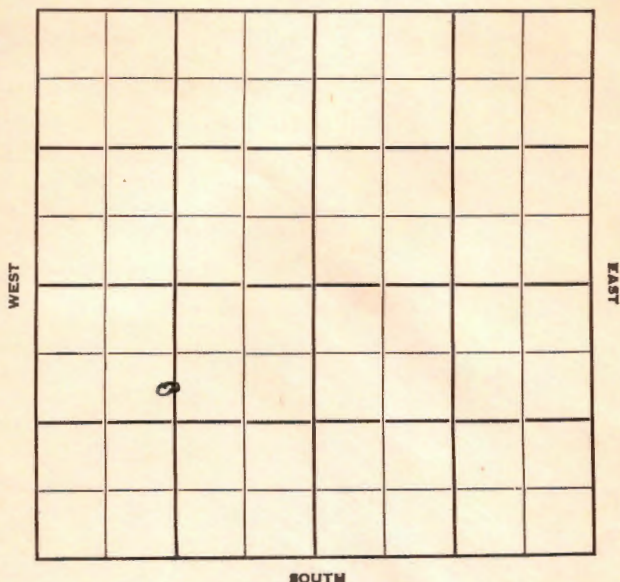


KANSAS

Kearny

Section 18 Township 24 Range 36WWell No. 1 Loucks "A"Company Champlin R. f.Hugoton
NORTH

KANSAS

Kearny

Sec. 18 Twp. 24 R. 36W

Well No. #1 Loucks "A" Farm

Champlin Ref.

Company

Hugoton Pool

Ft. from N. Line

1380'


Ft. from S. Line

Ft. from E. Line

1230'

Ft. from W. Line

C S L N $\frac{1}{2}$ SW

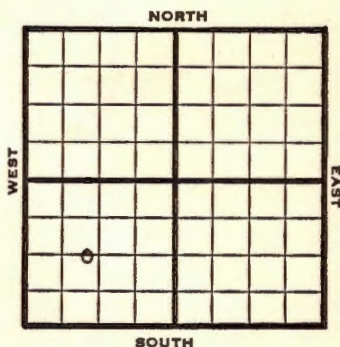

1949

Elev. 3223' REPORT

5/4

RUR

5/10

"

5/18

8" @ 700'

5/25

Drlg. 2490'

6/1

TD 2700'

5" @ 2673'

6/7

"

6/15

"

6/21

TD 2702'

Acid 3000

486 shots 2512-2648

Acid 13,500

6/28

Acid 16,000

7/6

"

7/12

"

7/20

Complete

5" @ 2673'

Perf. 19500acid

D A 2,309,000 gas 402#.R.RE

TD 2700'

COMPLETED

Map No. _____ Sec. 18 Twp. 24 R. 36W

Well No. 1 Loucks "A"

Champlin Ref. _____ Company _____

FIRST REPORT

Contractor _____

C S L N $\frac{2}{2}$ SW


SECTION PLAT

_____ Ft. from N. Line

1380 Ft. from S. Line

_____ Ft. from E. Line

1230 Ft. from W. Line

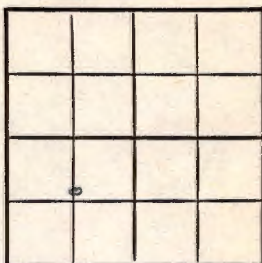

Kearny County

RECORD

Location _____

Rig up _____

Drilling and Remarks:

R U R

Cased _____ in., _____ ft.

Sand _____

Gas _____

Oil _____

Total Depth _____

PRODUCTION

1st 24 hrs. Nat. _____

1st 24 hrs. after shot _____

Gas _____ Cu. Ft.

Dry Hole _____

Abandoned _____

Date

MAY 4 1949

19

S. J. LEWIS

Scout

Hugoton Pool

Map No. Sec. 18 Twp. 24 R. 36WWell No. 1 Louchs "A"

Champlin Ref.

Company

COMPLETE

Contractor

C S L N $\frac{1}{2}$ SWE 13223
SECTION PLAT

Ft. from N. Line

1380

Ft. from S. Line

Ft. from E. Line

1230

Ft. from W. Line

Kearny County

Location

Rig up

Drilling and Remarks:

5" C 2672

Prof. 1950000000

DA. 2,309,000

402-2 R

RECORD

Cased in., ft.Sand Gas Oil Total Depth 2740

PRODUCTION

1st 24 hrs. Nat. 1st 24 hrs. after shot Gas Cu. Ft.Dry Hole Abandoned

Date

JUL 20 1949

19

S. J. LEWIS

Scout