


KANSAS

Kearny county

Section 24 Township 24 Range 36-W

Well No. #13, Campbell

Company Fin-Ker

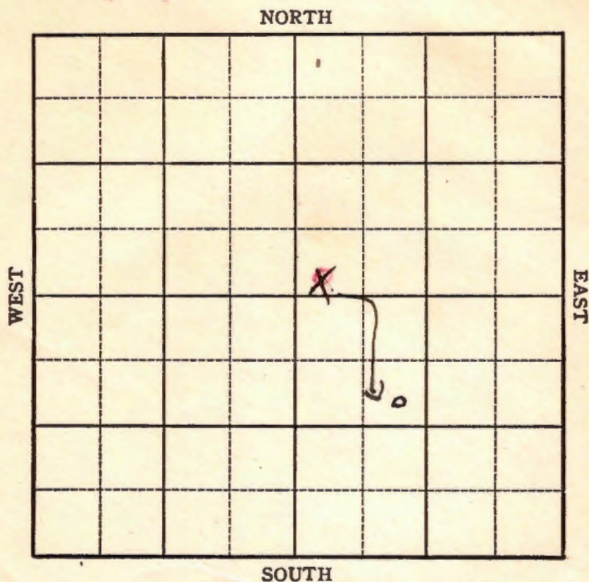

Sec. 24 Twp. 24 R. 36WWell No. 13 Campbell FarmFin-Ker Company

Hugoton


Ft. from N. Line

1500300 Ft. from S. Line1500 Ft. from E. Line300

Ft. from W. Line

SE NW SE

SW NE

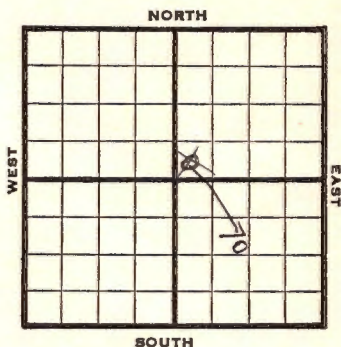1946 Elev. 2978' REPORT

11/13	Drlg 1160'
11/20	Drlg 1259'
11/27	1300 SD
12/10	10" @ 1572'
12/17	"
1947	
1/4	10" @ 1572'
1/8	"
1/15	"
1/21	TD 2682'
1/30	" "
2/5	" "
2/12	" "
2/19	" "

OVER

2/26

7" @ 2673'

Perf

65,000 Acid

4,581,000 Gas

398# RPr

TD 2682'

COMPLETED

Map No. _____ Sec. 24 Twp. 24 R. 36W

Well No. 13 Campbell

Fin-Ker

Company


COMPLETE

Contractor

SE NW SE

E1298

SECTION PLAT

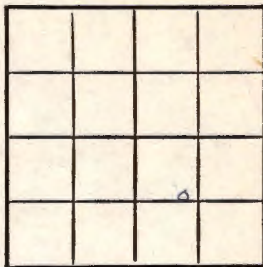

_____ Ft. from N. Line

1500 Ft. from S. Line

1500 Ft. from E. Line

_____ Ft. from W. Line

Kearny County

Location _____

Rig up _____

Drilling and Remarks:

7" @ 2673

Perf

650000 acq

4,587,000 Gas

398 R/A

RECORD

Cased _____ in., _____ ft.

Sand _____

Gas _____

Oil _____

Total Depth 2682

PRODUCTION

1st 24 hrs. Nat. _____

1st 24 hrs. after shot _____

Gas _____ Cu. Ft.

Dry Hole _____

Abandoned _____

Date

FEB 26 1947 19

S. J. LEWIS Scout

Kansas

Map No. _____ Sec. 24 Twp. 24 R. 36WWell No. 13 Campbell

Fin-Ker

Company _____

FIRST REPORT

Contractor _____

SW NE

SECTION PLAT

		2	

_____ Ft. from N. Line

300 Ft. from S. Line

_____ Ft. from E. Line

300 Ft. from W. Line

Kearny County

Location _____

Rig up _____

Drilling and Remarks:

drlg. 1160

RECORD

Cased _____ in. _____ ft.

Sand _____

Gas _____

Oil _____

Total Depth _____

PRODUCTION

1st 24 hrs. Nat. _____

1st 24 hrs. after shot _____

Gas _____ Cu. Ft.

Dry Hole _____

Abandoned _____

Date

NOV 13 1946

19

S. J. LEWIS

Scout

Kansas

Map No. _____ Sec. 24 Twp. 24 R. 36WWell No. 13 Campbell

Fin-Ker


Company

CORRECTION

Contractor

SE NW SE

SECTION PLAT

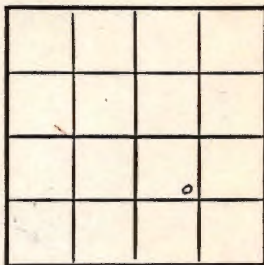

_____ Ft. from N. Line

1500 Ft. from S. Line1500 Ft. from E. Line

_____ Ft. from W. Line

Kearny County

Location _____

Rig up _____

Drilling and Remarks:

Reported

SW NE

RECORD

Cased _____ in., _____ ft.

Sand _____

Gas _____

Oil _____

Total Depth _____

PRODUCTION

1st 24 hrs. Nat. _____

1st 24 hrs. after shot _____

Gas _____ Cu. Ft.

Dry Hole _____

Abandoned _____

Date

DEC 4 1946 19

S. J. LEWIS

Scout