

KANSAS

Kearny

Section 28 Township 24 Range 36-WWell No. 1 HicksCompany Cities Service

Hugoton Pool

NORTH

WEST

			0				

EAST

SOUTH

KANSAS Kearny

Sec. 28 Twp. 24 R. 36W

Well No. #1 Hicks Farm

Cities Service Company


100 Ft. from N. Line

 Ft. from S. Line

100 Ft. from E. Line

 Ft. from W. Line

NE SW

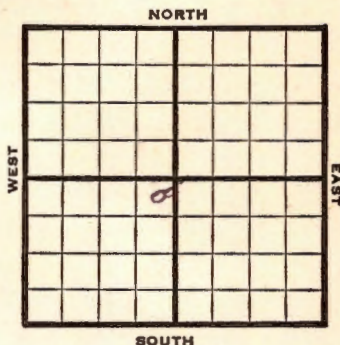

1947

Elev. 3038' REPORT

10/1	Location
10/15	8" @ 800' WOC
10/22	Drlg. 1892'
10/29	TD 2655' 5" @ 2654' RUST
11/5	"
11/12	"
11/19	"
11/25	"
12/3	"
12/10	190 shots 2556-94' 140 shots 2504-32' 110 shots 2444-66' 180 shots 2386-2422' 40 shots 2358-66' - 3800 acid.
12/17	Total 55000 acid, 6,470,000 gas.
12/23	5" @ 2654' Perf. 55000 acid 13,600,000 gas. 425# R. Pr. TD 2655'

COMPLETED

Map No. _____ Sec. 28 Twp. 24 R. 36W

Well No. 1 Hicks

Cities Service Company

FIRST REPORT Contractor

NE SW

100 Ft. from N. Line

_____ Ft. from S. Line

100 Ft. from E. Line

_____ Ft. from W. Line

Kearny County

SECTION PLAT

Location X

Rig up _____

Drilling and Remarks:

RECORD

Cased _____ in., _____ ft.

Sand _____

Gas _____

Oil _____

Total Depth _____

PRODUCTION

1st 24 hrs. Nat. _____

1st 24 hrs. after shot _____

Gas _____ Cu. Ft.

Dry Hole _____

Abandoned _____

Date

OCT 1 1947 19 S. J. LEWIS Scout

Map No. _____ Sec. 28 Twp. 24 R. 36W

Well No. 1 Hicks

Cities Service

Company

COMPLETE

Contractor

NE SW

E1,3038.
SECTION PLAT

	0		

100 Ft. from N. Line

_____ Ft. from S. Line

100 Ft. from E. Line

_____ Ft. from W. Line

Kearny County

Location _____

Rig up _____

Drilling and Remarks:

5' C2654

Pay.

5500 acid

13,600,000 Gas

*425 *R B*

RECORD

Cased _____ in., _____ ft.

Sand _____

Gas _____

Oil _____

Total Depth *2155.*

PRODUCTION

1st 24 hrs. Nat. _____

1st 24 hrs. after shot _____

Gas _____ Cu. Ft.

Dry Hole _____

Abandoned _____

Date

DEC 23 1947

19

S. J. LEWIS

Scout