

KANSAS

Kearny

Section 34 Township 24 Range 36

Well No. 1 Beaty

Company Cities Service

Hugoton NORTH

WEST

EAST

SOUTH

KANSAS

Kearny

Sec. 34 Twp. 24 R. 36-W

Well No. 1 Beaty Farm

Cities Service Company


Hugoton Pool

100 Ft. from N. Line

 Ft. from S. Line

 Ft. from E. Line

100 Ft. from W. Line

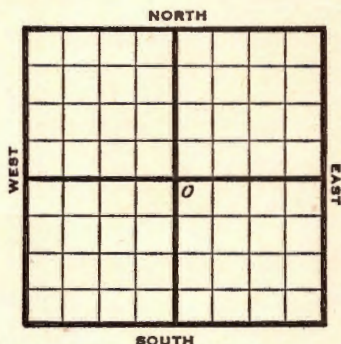

NW SE

1947 Elev. 3001 REPORT

9/3	Loc.	
9/10	"	
9/18	8" @ 800'	
	Drlg. 1310'	
9/24	TD 2602'	
	5" @ 2601'	
	RHST	
10/1	"	
10/8	180 shots	2515-52
	140 "	2458-86
	80 "	2404-20
	90 "	2362-80
	40 "	2350-58
	60 "	2814-26
10/15	44,000 Acid	
10/22	"	
10/29	5" @ 2601	
	Perf 43,500 Acid	
	22,800,000 Gas	
	TD 2602'	
	420# RPr	

COMPLETED

Map No. _____ Sec. 34 Twp. 24 R. 36W

Well No. 1 Beaty

Cities Service

Company

FIRST REPORT

Contractor

NW SE

SECTION PLAT

100 Ft. from N. Line

_____ Ft. from S. Line

1 Ft. from E. Line

100 Ft. from W. Line

Kearny County

Location X

Rig up _____

Drilling and Remarks:

RECORD

Cased _____ in., _____ ft.

Sand _____

Gas _____

Oil _____

Total Depth _____

PRODUCTION

1st 24 hrs. Nat. _____

1st 24 hrs. after shot _____

Gas _____ Cu. Ft.

Dry Hole _____

Abandoned _____

Date

SEP 3 1947 19

S. J. LEWIS Scout

Map No. 0 Sec. 34 Twp. 24 R. 36W

Well No. 1 Beaty

Cities Service Company

COMPLETE

Contractor

NW SE

E1,300/
SECTION PLAT

100 Ft. from N. Line

 Ft. from S. Line

 Ft. from E. Line

100 Ft. from W. Line

		6	

Kearny County

Location

Rig up

Drilling and Remarks:

5" @ 2601

Perf.

13,500 Rad' C

22,800,000 Gas

420 # R/A

RECORD

Cased in., ft.

Sand

Gas

Oil

Total Depth 2602

PRODUCTION

1st 24 hrs. Nat.

1st 24 hrs. after shot

Gas Cu. Ft.

Dry Hole

Abandoned

Date

OCT 29 1947 19

S. J. LEWIS

Scout