


KANSAS

Section 35 Township 24 Range 36W

Well No. 1 Beyer

Company Cities Service

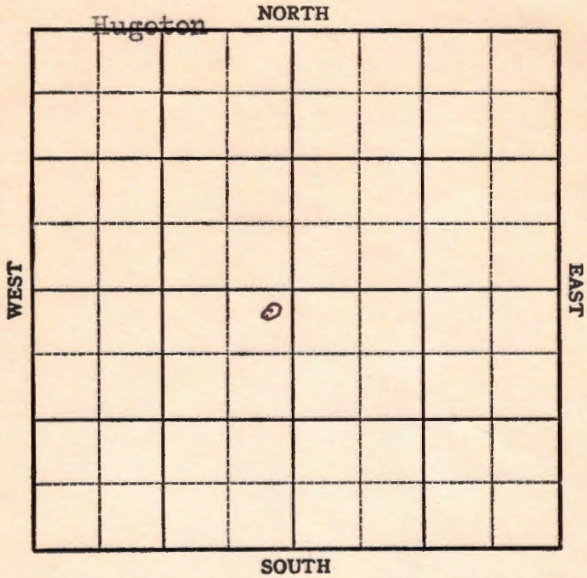

**KANSAS**

**Kearny**

Sec. 35 Twp. 24 R. 36-W

Well No. 1 Beymer Farm \_\_\_\_\_

Cities Service Company \_\_\_\_\_

Hugoton Pool


NORTH

250 Ft. from N. Line

\_\_\_\_\_ Ft. from S. Line

100 Ft. from E. Line

\_\_\_\_\_ Ft. from W. Line

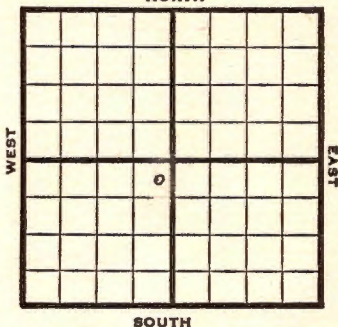

NE SW

1947 **Elev. 2996'** REPORT

9/3 Loc.

9/10 8" @ 800'  
TD 2635'  
5" @ 2634'  
RUST

9/17 "

9/24 "

10/1 "

10/8 "

10/15 150 shots 2498-2528'  
70 " 2440-54  
70 " 2400-14  
50 " 2384-94  
50 " 2352-62

30,000 Acid

10/22 12,000 acid

11/5 5" @ 2634'

Perf.

15,000 acid

18,600,000 G<sup>A</sup>s

Rock Pressure 394#

Total Depth 2635'

**COMPLETED**

Map No. \_\_\_\_\_ Sec. 35 Twp. 24 R. 36W

Well No. 1 Beymer

Cities Service \_\_\_\_\_ Company

**FIRST REPORT**

Contractor \_\_\_\_\_

NE SW

**SECTION PLAT**

250 Ft. from N. Line


\_\_\_\_\_ Ft. from S. Line

100 Ft. from E. Line

\_\_\_\_\_ Ft. from W. Line

Kearny County

Location X

**RECORD**

Rig up \_\_\_\_\_

Cased \_\_\_\_\_ in., \_\_\_\_\_ ft.

Drilling and Remarks: \_\_\_\_\_

Sand \_\_\_\_\_

Gas \_\_\_\_\_

Oil \_\_\_\_\_

Total Depth \_\_\_\_\_

**PRODUCTION**

1st 24 hrs. Nat. \_\_\_\_\_

1st 24 hrs. after shot \_\_\_\_\_

Gas \_\_\_\_\_ Cu. Ft.

Dry Hole \_\_\_\_\_

Abandoned \_\_\_\_\_

Date

SEP 3 1947 19

S. J. LEWIS Scout

Map No. \_\_\_\_\_ Sec. 35 Twp. 24 R. 36W

Well No. 1 Beymer

Cities Service

Company \_\_\_\_\_

COMPLETE

Contractor \_\_\_\_\_

NE SW

*E 1, 2994*  
SECTION PLAT

250 Ft. from N. Line

\_\_\_\_\_ Ft. from S. Line

100 Ft. from E. Line

\_\_\_\_\_ Ft. from W. Line

		o	

Kearny County

Location \_\_\_\_\_

Rig up \_\_\_\_\_

Drilling and Remarks:

*5" @ 2634*  
*Prof.*  
*15000 acid*  
*18,600,000 Gal*

*294 #2 B*

RECORD

Cased \_\_\_\_\_ in., \_\_\_\_\_ ft.

Sand \_\_\_\_\_

Gas \_\_\_\_\_

Oil \_\_\_\_\_

Total Depth 2635

PRODUCTION

1st 24 hrs. Nat. \_\_\_\_\_

1st 24 hrs. after shot \_\_\_\_\_

Gas \_\_\_\_\_ Cu. Ft.

Dry Hole \_\_\_\_\_

Abandoned \_\_\_\_\_

Date

NOV 5 1947

19

S. J. LEWIS

Scout