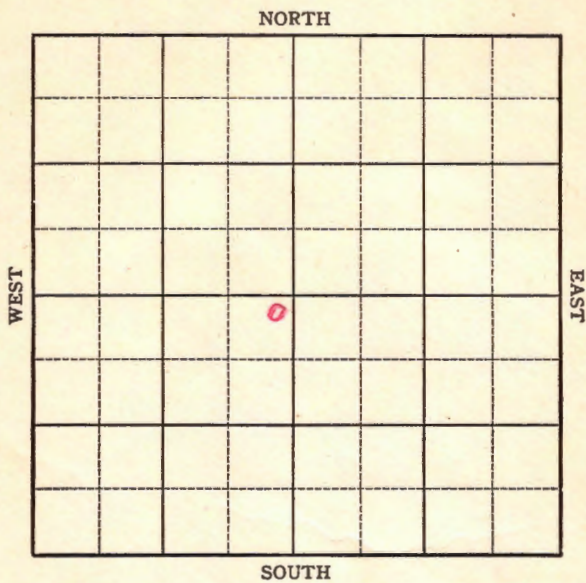


KANSAS

Kearny county

Section 29 Township 24 Range 36-WWell No. #1, ShusterCompany Cities Service Oil Company

KANSAS

Kearny ✓

Sec. 29 Twp. 24 R. 36W

Well No. #1 Shuster Farm

Cities Service Company

Hugoton


100 Ft. from N. Line

Ft. from S. Line

100 Ft. from E. Line

Ft. from W. Line

NE SW

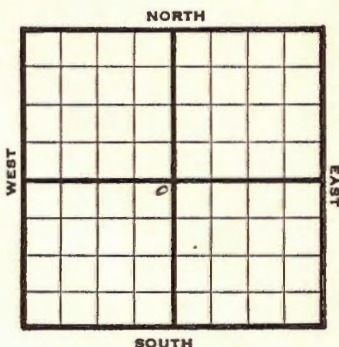

1946		REPORT	
		Elev. 3066'	
10/16	Location		
10/22	"		
10/29	"		
11/6	"		
11/12	"		
11/20	"		
11/27	"		
12/3	Surface hole		
12/10	Drlg 845'		
12/17	8" @ 841'		
	Drlg 1325'		
1947			
1/4	TD 2640'		
	5" @ 2639', RUST		
1/8	" "		
1/15	120 shots 2570-90		
	160 " 2508-40		
	100 " 2450-70		
	170 " 2398-2430		
1/21	100 shots 2570-90		
1/30	19,000 Acid		
2/5	" "		
OVER			

OVER

2/12 19000 Acid

2/19 " "

2/26 " "

3/5 5" @ 2639'
Perf
40,000 Acid
12,500,000 Gas
405# R Pr
TD 2640'

COMPLETED

KANSAS

Map No. _____ Sec. 29 Twp. 24 R. 36W

Well No. 1 Shuster

Cities Service Company

FIRST REPORT Contractor

NE SW

SECTION PLAT

100 Ft. from N. Line

Ft. from S. Line

100 Ft. from E. Line

Ft. from W. Line

	0		

Kearny County

Location X

Rig up

Drilling and Remarks:

RECORD

Cased _____ in., _____ ft.

Sand _____

Gas _____

Oil _____

Total Depth _____

PRODUCTION

1st 24 hrs. Nat. _____

1st 24 hrs. after shot _____

Gas _____ Cu. Ft.

Dry Hole _____

Abandoned _____

Date

OCT 1 6 1946 19

S. J. LEWIS Scout

Kansas

Hugoton Pool

Map No. _____ Sec. 29 Twp. 24 R. 36WWell No. 1 Shuster

Cities Service

Company

COMPLETE

Contractor


NE SW

F13066
SECTION PLAT100 Ft. from N. Line

_____ Ft. from S. Line

100 Ft. from E. Line

_____ Ft. from W. Line

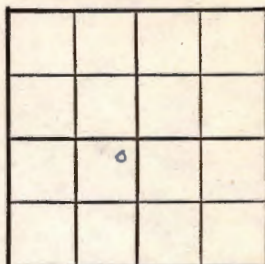

Kearny County

Location _____

Rig up _____

Drilling and Remarks:

5102639

Ref.

40000 aced

12,500,000 Gal.

40.5" R/P

RECORD

Cased _____ in., _____ ft.

Sand _____

Gas _____

Oil _____

Total Depth 2240

PRODUCTION

1st 24 hrs. Nat. _____

1st 24 hrs. after shot _____

Gas _____ Cu. Ft.

Dry Hole _____

Abandoned _____

Date

MAR 5 1947 19

S. J. LEWIS

Scout