

Reno

DX 78-1

36

24

KANSAS

5W

Section _____ Township _____ Range _____


Well No. #1 Gillmore ('A')

Company Leben & ~~CRA~~

NORTH

WEST

EAST

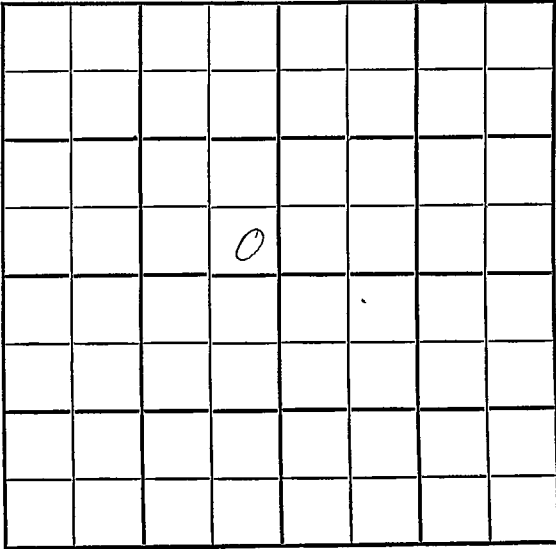

SOUTH

WILDCAT

County Reno

Elev. _____

Sec. 36Twp. 24Rge. 5WCompany Leben & CRAFarm Name GillmoreNo. 1

TOPS	DEPTH	LOG	DATUM
Anh.			
TP.			
H.			
Tr.			
Dg.			
Bl.			
L.			
K.C.			
B.K.C.			
Ce.			
C.			
M.			
M.			
K.			
Mz.			
Me.			
V.			
S.			
S.			
A.			
R.			
Pe.			
G.			
T.D.			

Loc. in Sec. _____


SE SE NW

Geol. _____

Contr. _____

Leben Tools

Pool _____

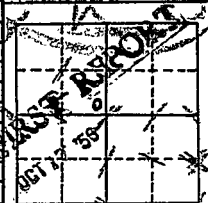Wildcat.

Date Comm. _____

WOR from Leben Seeley2201 1 x 100

County Heno Elev. 1504 Co.
 Sec. 36 Twp. 24 Rgs. 5W
 Company Leben & Son
 Farm Name Gillmore "A" No. 1

TOPS	DEPTH	LOG	DATUM	Loc. in Sec.
Anh.				SE SE NW
Tr.				
H.	2457	2457		
Tr.				
Dg.	2480	2480		
Bl.	2648	2680	2677	
L.	2669	2698	2691	
K.C.				Geol.
B.K.C.				Contr.
Ce.				
C.		3392		Leben Tools
M.		3400		
M.				Pool
K.		3620		Wildcat
Mz.				
Mo.				
V.		3830		
S.	2d	3849		ABANDONED
S.				
A.				
R.				
Pe.				
G.				
T.D.	3869			

Date Comm. Midstates F.O.

WOR from: Leben Seeley OCT 24 '56

BUR OCT 31 '56 SKID RIG 90'

South SPD 10-27-56 8:18

684 10975 NOV 7 '56 103385 NOV 13 '56

DST 33405-3440 up 1 hr

210' WCM BHP 600/20" DST 3843

-53 1 hr 2580' SW. FP 205-1140

BHP 1315/20"

DEW