

KANSAS

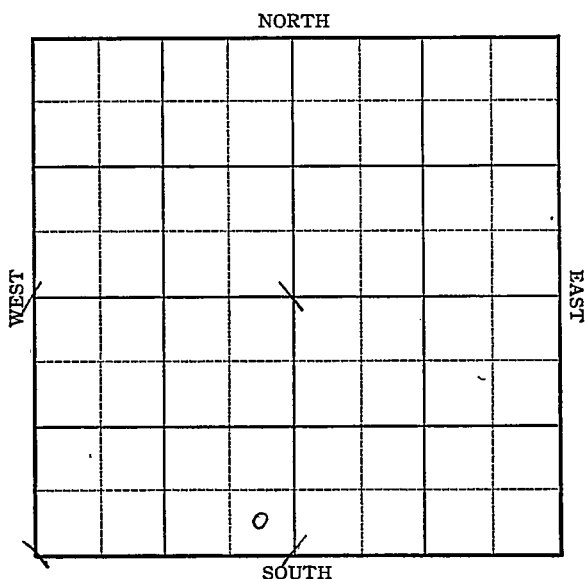
Stafford

FORM 51 5M 1-42 PETROL

Section 36 Township 24 Range 13-W

Well No. #1 James

Company Continental



KANSAS

Stafford

Sec. 36 Twp. 24 R. 13-W

Well No. #1 James Farm

Continental Company

Wildcat

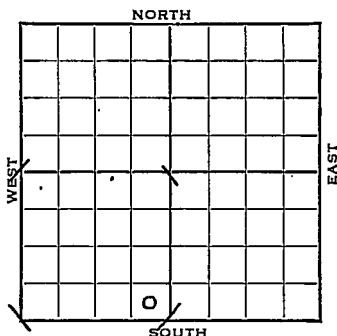
1 Ft. from N. Line

330 Ft. from S. Line

330 Ft. from E. Line

330 Ft. from W. Line

Elev. 1910



1943

REPORT

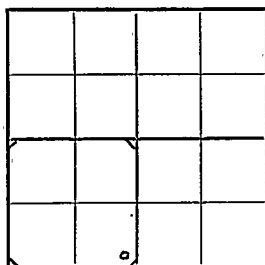
2/24 Derrick.
3/3 10" Casing set 280
Drlg. 350'
3/10 Topeka 3000
Drlg. 3250'
3/17 Drlg. 4070'
3/24 Lans 3592'
Congl. 3927
Viola 4007
Sinp. sd. 4124
Arb. 4179
T.D. 4234'
No shows.

ABANDONED

KANSAS
Map No. 83 Sec. 36 Twp. 24 R. 13WWell No. 1 **James**Continental Company**FIRST REPORT** Contractor

SE SW

SECTION PLAT

 Ft. from N. Line330 Ft. from S. Line330 Ft. from E. Line330 Ft. from W. Line**WILDCAT**Location Rig up

Drilling and Remarks:

Derrick**RECORD**Cased in., ft.Sand Gas Oil Total Depth **PRODUCTION**1st 24 hrs. Nat. 1st 24 hrs. after shot Gas Cu. Ft.Dry Hole Abandoned

Date

FEB 24 1943 19 S. I. LEWIS Scout

KANSAS

Stafford

Map No. 83 Sec. 36 Twp. 24 R. 13WWell No. 1 JamesContinental

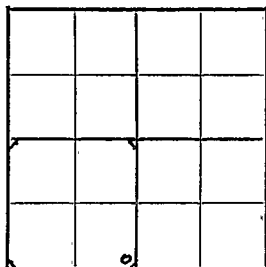
Company

CORRECTION

Contractor

SE SW

SECTION PLAT

 Ft. from N. Line330 Ft. from S. Line330 Ft. from E. Line Ft. from W. Line

WILDCAT

Location Rig up Drilling and Remarks: Reported 330' from WestLine

RECORD

Cased in., ft.Sand Gas Oil Total Depth

PRODUCTION

1st 24 hrs. Nat. 1st 24 hrs. after shot Gas Cu. Ft.Dry Hole Abandoned

Date

FEB 24 194319S. J. LEWIS Scout

KANSAS

Stafford

Map No. 83 Sec. 36 Twp. 24 R. 13WWell No. 1 JamesContinental

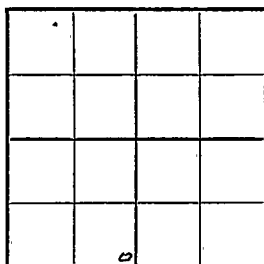
Company

ABANDONED

Contractor

SE SW

SECTION PLAT

 Ft. from N. Line330 Ft. from S. Line330 Ft. from E. Line Ft. from W. Line

WILDCAT

Location Rig up

Drilling and Remarks:

*Lane 3592**Dog 1 3927**Vista 4007**Imp Sol 4124**Cr 4179**No show*

RECORD

Cased in., ft.Sand Gas Oil Total Depth 4234

PRODUCTION

1st 24 hrs. Nat. 1st 24 hrs. after shot Gas Cu. Ft.Dry Hole Abandoned

Date

MAR 24 1943

19

S. J. LEWIS

Scout