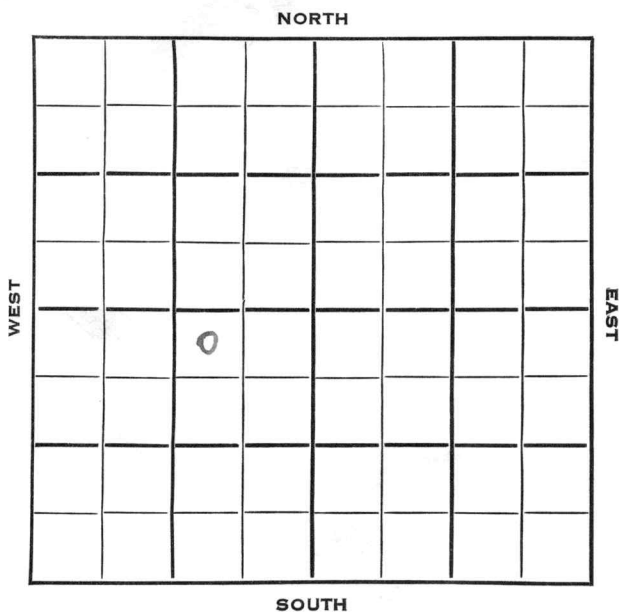


Section 36 Township 24 Range 14 WWell No. # 1 HowellCompany Natural Gas & Oil

Stafford

KANSAS

SEC.	TWP.	R.
36	24	14 W ✓

WELL NO.

1 Howell

FARM

COMPANY

Natural Gas & Oil

CONTRACTOR

Natural Gas & Oil

SE Koelsch Pool


330 Ft. from N. Line

Ft. from S. Line

990 Ft. from E. Line

Ft. from W. Line

NW NE SW

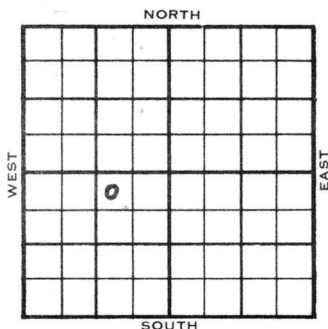

	ELEVATION	REPORT
1953	1951'	
10/14	RUR	
10/21	10" @ 200'	
	Drlg 3100'	
10/28	Drlg 4099'	
11/4	Heeb 3469, KC 3634, DST 3649'-88' 1 hr, 35' M DST 3759'-3804' 1 hr, 40' M 800# B KC 3914, Miss 3992, V 4059, Simp 4188' DST 4207'-18' 1 hr, 30' M Arb 4238, DST 4240-50' 1 hr, 210' Sulp. wtr. 1390# FP 80 to 160 Drlg 4705'	
11/11	Prec Cam 4736 TD 4752' 7" @ 4293' WOC	

OVER


1953
12/2

Spud 10-13-53 SWD well TD 4752
10" @ 200 Heeb 3469 KC 3634
DST 3649-88 open 1 hr rec 35' mud
DST 3759-3804 open 1 hr rec 40' mud
800# B KC 3914 Miss 3992
Viola 4059 Simp 4188
DST 4207-18 open 1 hr rec 30' mud
Arb. 4238'
DST 4240-50 open 1 hr rec 210' sul
wtr. 1390# PreCamb. 4736'
TD 4752' 7" @ 4293 CO to 4752
2000 A
Comp. 250 BSWPH

ABANDONED

J. G. McGEHEE

County Stafford State Kansas
 Sec. 36 (Blk. 24 (Sur. 14W Map No.
 (Twp.) (Rge.)
 Operator Natural Gas & Oil
 Well No. 1 Farm Howell
 Elev. 1951 Location NW NE SW

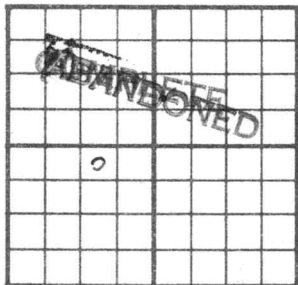

330 Ft. From N Line SW
990 Ft. From E Line Quarter
 1st. Report
 Completion DEC 2 1953
 Remarks SE Koelsch Pool
Natural Gas & Oil - Contr.
 Spudding Date 10-13-53

Drlg. Data SWD well TD 4752
10" @ 200 Heeb. 3469 KC 3634
DST 3649-88 open 1 hr. Rec. 35' mud
DST 3759-3804 open 1 hr. Rec. 40' mud
800# B KC 3914 Miss. 3992 Viola 4059
Simp. 4188 DST 4207-18 open 1 hr.
Rec. 30' mud Arb. 4238 DST 4240-50
open 1 hr. Rec. 210' sul. wtr. 1390#
PreCamb. 4736 TD 4752 7" @ 4293
CO to 4752 2000 A Comp. 256 bswph

J. G. McGEHEE