


Stafford

KANSAS

Section 36 Township 24 Range 11W

Well No. #2 Kachelman

Company Westgate-Greenland

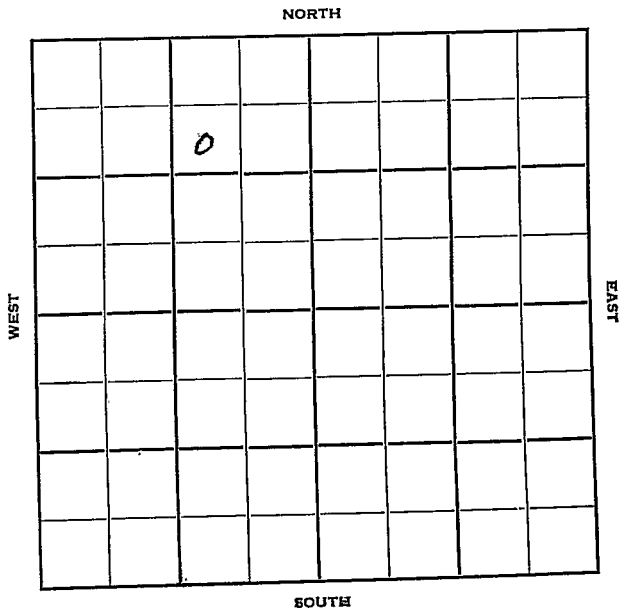


Stafford

KANSAS ✓

Sec. 36 Twp. 24 R. 14WWell No. #2 Kachelman FarmWestgate-Greenland CompanyW-G - Contr. Contractor990 Ft. from N. Line       Ft. from S. Line990 Ft. from E. Line       Ft. from W. Line

SW NE NW

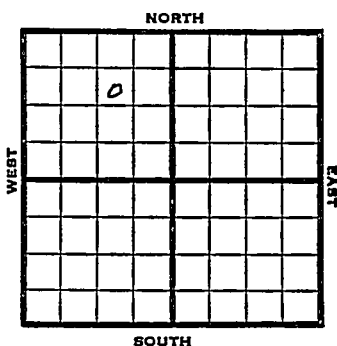

1953

Elev. 1946'

## REPORT

3/18

Spudded 3/11/53

8" @ 200

Drlg. 4160

3/26

Drlg. 4107'

4/2

RTD 4210

5" @ 4209

4/9

NR

4/16

"

4/22

Spud 3-11-53

Oil Well

TD 4210

8" @ 200

Heeb 3448, Lans 3615,

DST 3662-94, opn 1 hr., rec. 60' ocm,  
360' muddy sw, 870#DST 3734-48, opn 1 hr., rec. 30'  
vsocm, 295#B KC 3884, Viola 4002, Simp 4143,  
Simp'sd 4154DST 4155-66, opn 1 hr., rec. 60' ocm,  
195#

Arb 4181

DST 4186-4210, opn 1 hr., rec. 3822'  
gassy oil, 1405#

TD 4210

5" @ 4209

CO to 4210, 119/4182-4208, FU 3800'  
oil 2 hrs., S/28 boph 4 hrs.Comp. 3000 bopd **COMPLETED**

County Stafford State Kansas  
 Sec. 36 (Blk. Twp.) 24 (Sur. Rge.) 14W Map No. \_\_\_\_\_  
 Operator Westgate-Greenland  
 Well No. 2 Farm Kachelman  
 Elev. \_\_\_\_\_ Location SW NE NW

|  |   |  |  |  |  |
|--|---|--|--|--|--|
|  |   |  |  |  |  |
|  | 0 |  |  |  |  |
|  |   |  |  |  |  |
|  |   |  |  |  |  |
|  |   |  |  |  |  |
|  |   |  |  |  |  |
|  |   |  |  |  |  |
|  |   |  |  |  |  |

990 Ft. From N Line NW  
 990 Ft. From E Line Quarter  
 1st. Report MAR 18 1953  
 Completion \_\_\_\_\_  
 Remarks \_\_\_\_\_  
W-G - Contr.  
 Spudding Date 3-11-53

Drilg. Data

8" @ 200 drlg. 1460

|          |                    |                |             |
|----------|--------------------|----------------|-------------|
| County   | Stafford           | State          | Kansas      |
| Sec.     | 36 (Blk. Twp.)     | 24 (Sur. Rge.) | 14W Map No. |
| Operator | Westgate-Greenland |                |             |
| Well No. | 2                  | Farm           | Kachelman   |
| Elev.    | 1946               | Location       | SW NE NW    |

|              |        |         |
|--------------|--------|---------|
| 990 Ft. From | N Line | NW      |
| 990 Ft. From | E Line | Quarter |

### 1st. Report

Completion APR 22 1953

Remarks

W-G - Contr.

Spudding Date 3-11-53

|                 |                |                   |
|-----------------|----------------|-------------------|
| Drilg. Data     | Oil well       | TD 4210           |
| 8" @ 200        | Heeb. 3448     | Lans. 3615        |
| DST 3662-94     | open 1 hr.     | Rec. 60' ocm      |
| 360' muddy sw   | 870#           | DST 3734-48       |
| open 1 hr.      | Rec. 30' vsocm | 295#              |
| B KC 3884       | Viola 4002     | Simp. 4143        |
| Simp. sd. 4154  | DST 4155-66    | open 1 hr.        |
| Rec. 60' ocm    | 195#           | Arb. 4181         |
| DST 4186-4210   | open 1 hr.     | Rec. 3822'        |
| gassy oil       | 1405#          | TD 4210 5" @ 4209 |
| CO to 4210      | 119/4182-4208  | FU 3800' oil      |
| 2 hr.           | S/ 28 boph     | 4 hr.             |
| Comp. 3000 bopd |                |                   |

**J. G. McGEHEE**