

Stafford


FORM 51

KANSAS

Section 36 Township 24 Range 14W

Well No. #5 Kackleman (Kachelman)

Company Natural Gas & Oil

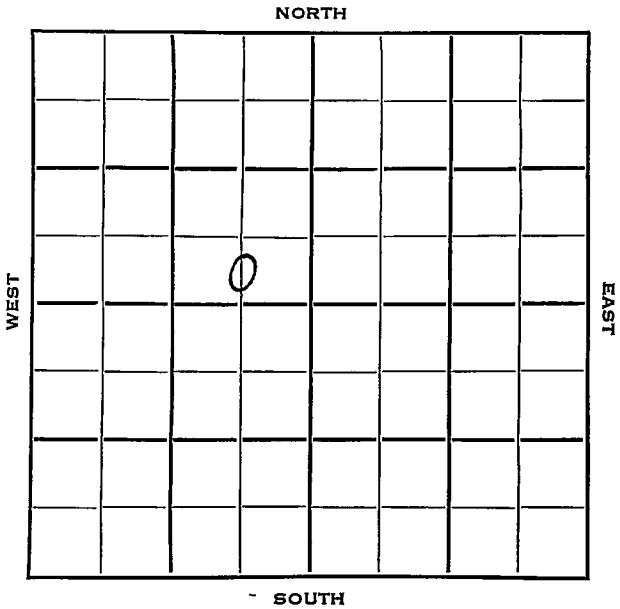

Stafford

KANSAS

Sec. 36 Twp. 24 R. 11WWell No. #5 Kackleman FarmNatural Gas & Oil CompanyNat. Gas & Oil ContractorS. Happy Valley Pool


NORTH

Ft. from N. Line

330 Ft. from S. Line660 Ft. from E. Line

Ft. from W. Line

C S L SE NW

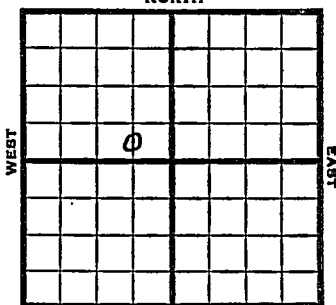

SOUTH

1953 Elev. 1952' REPORT

7/29 Spud 7-24-53

10" @ 204'

Anhy 840'

Drlg 1900'

8/5 Drlg 3514'

8/12 N.R.

9/16 Spud 7-24-53

Oil Well

TD 4220'

10" @ 204'

Anhy 840, Heeb 3464, Lans 3630

DST 3752-68 opn 1 hr, rec 35' wcm, 80#

B KC 3908, Cong 3969, Viola 4023,

Simp. Sh 4167, Simp sd. 4184, Arb

4211

DST 4185-95 opn 1 hr, rec 25' o & gcm

60' hocom 90' gas 1280#

DST 4212-16 opn 1 hr, rec 470' gas,

1410' oil, 1460#

TD 4220'

7" @ 4219'

48/ 4180-93 32/ 4181-91 S/ 10

boph 200 mud acid sd-frac S/ 3 1/2 boph

8 hr.

Comp. 110 bopd.

COMPLETED

County **Stafford** State **Kansas**

Sec. 36 (Blk.) 24 (Sur.) 14W Map No.

Operator **Natural Gas & Oil**

Well No. **5** Farm **Kacklemen**

Elev.	Location	C	S	L	SE	NW
-------	----------	---	---	---	----	----

0

FIRST RETURN

330Ft. From S Line NW

660 Ft. From E Line Quarter

1st. Report **JUL 20 1953**

Completion

Remarks

Nat. Gas & Oil - Contr.

Spudding Date 7-24-53


Drig. Data

S. Happy Valley Pool.

10th @ 204 Anhy 840 drlg. 1900

J. G. McGEHEE

County Stafford State Kansas
 Sec. 36 (Blk.) 24 (Sur.) 14W Map No.
 Operator Natural Gas & Oil
 Well No. 5 Farm Kackleman
 Elev. 1952 Location C S L SE NW

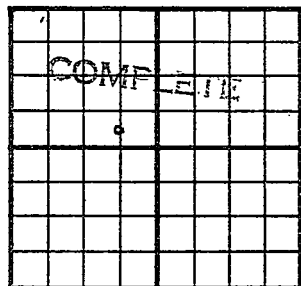

330 Ft. From S Line NW
660 Ft. From E Line Quarter

1st. Report

Completion SEP 16 1953

Remarks S. Happy Valley Pool

Nat. Gas & Oil - Contr.

Spudding Date 7-24-53

Drilg. Data Oil well TD 4220

10" @ 204 Anhy 840 Heeb. 3464

Lans. 3630 DST 3752-68 open 1 hr.

Rec. 35' wcm 80# B KC 3908

Cong. 3969 Viola 4023 Simp. sh. 4167

Simp. sd. 4184 Arb. 42ET DST 4185-95

open 1-hr. Rec. 25' o & gcm 60' hocm

90' gas 1280# DST 4212-16 open 1 hr.

Rec. 470' gas 1410' oil 1460#

TD 4220 7" @ 4219 48/ 4180-93

32/4181-91 S/ 10 goph 200 mud acid

sd-frac S/ 3½ boph 8 hr.

Comp. 110 bopd

J. G. McGEHEE