


Stafford

Section 36 Township 24 Range 11W

Well No. #1 Kachelman

Company Westgate-Greenland

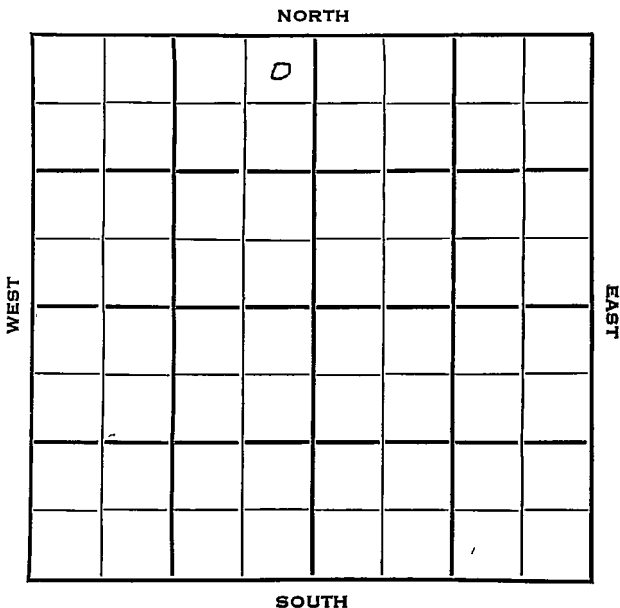


Stafford

KANSAS ✓

Sec. 36 Twp. 24 R. 14WWell No. #1 Kachelman FarmWestgate-Greenland CompanyWestgate-Greenland Contractor330 Ft. from N. Line Ft. from S. Line330 Ft. from E. Line Ft. from W. Line

NE NE NW

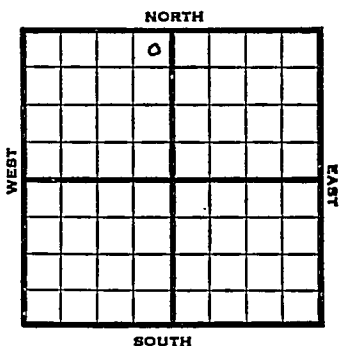

1953 Elev. 1947 REPORT

2/18 Spudding Date 2/13/53
8" @ 211 Drlg. 2180

2/26 Drlg. 4143

3/12 "

3/19 NR

3/25 Spud 2-13-53

Oil Well

TD 4232

8" @ 211

Heeb 3448, Tor 3464, Doug 3486, Br.
Lime 3585, Lans 3614DST 3668-91 open 1 hr. Rec 80' mud
1200#

BKC 3885, Kh 3968, Viola 4018

Simp. Sh 4146, Simp Sd. 4154

DST 4159-71 open 1 hr. Rec 15' mud
1380#

Arb 4182,

DST 4185-96 open 1 hr. Rec. 3805'
oil 1480#DST 4197-4208 open 1 hr. Rec 3655'
oil 1600#DST 4209-20 open 1 hr. Rec. 3900' oil
1440#


OVER

1953

Information brought forward

3/25 DST 4221-32 open 1 hr. Rec. 2460' sw
1615#
TD 4232
5" @ 4231
CO to 4230 118/4182-4206 FU 2400'
oil 2 hr. S/ 85 bo 2 hr.
Comp. 3000 bopd

COMPLETED

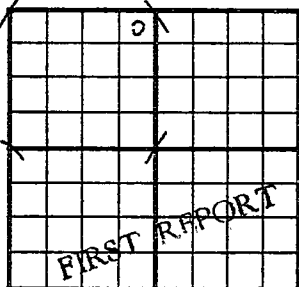County Stafford State KansasSec. 36 (Blk. Twp.) 24 (Sur. Rge.) 14W Map No.Operator Westgate-GreenlandWell No. 1 Farm KachelmanElev. Location NE NE NW330 Ft. From N Line NW330 Ft. From N Line Quarter1st. Report FEB 18 1953

Completion


Remarks

Westgate-Greenland - ContrSpudding Date 2-13-53

Drlg. Data

8" @ 211 drlg. 2180

County Stafford State Kansas
 Sec. 36 (Blk.) 24 (Sur.) 14W Map No. _____
 Operator Westgate-Greenland
 Well No. 1 Farm Kachelman
 Elev. 1947 Location NE NE NW

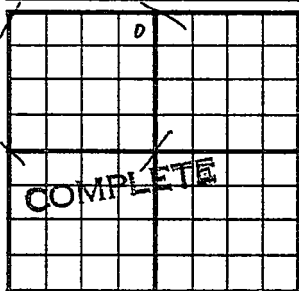

330 Ft. From N Line NW

330 Ft. From E Line Quarter

1st. Report

Completion MAR 25 1953

Remarks

W-G - Contr.

Spudding Date 2-13-53

Drlg. Data Oil well TD 4232

8" @ 211 Heeb. 3448 Tor. 3464

Doug. 3486 Br. lime 3585 Lans. 3614

DST 3668-91 open 1 hr. Rec. 80' mud

1200# B KC 3885 Kh. 3968 Viola 4018

Simp. sh. 4146 Simp. sd. 4154 DST 4159-71

open 1 hr. Rec. 15' mud 1380#

Arb. 4182 DST 4185-96 open 1 hr.

Rec. 3805' oil 1480# DST 4197-4208

open 1 hr. Rec. 3655' oil 1600#

DST 4209-20 open 1 hr. Rec. 3900' oil

1440# DST 4221-32 open 1 hr. Rec.

2460' sw 1615# TD 4232 5" @ 4231

CO to 4230 118/ 4182-4206 FU 2400' oil

2 hr. S/ 85 bo 2 hr. Comp. 3000 bopd

J. G. McGEHEE