


Section 36 Township 24 Range 11W

Well No. 3 Kachelman

Company Westgate-Greenland

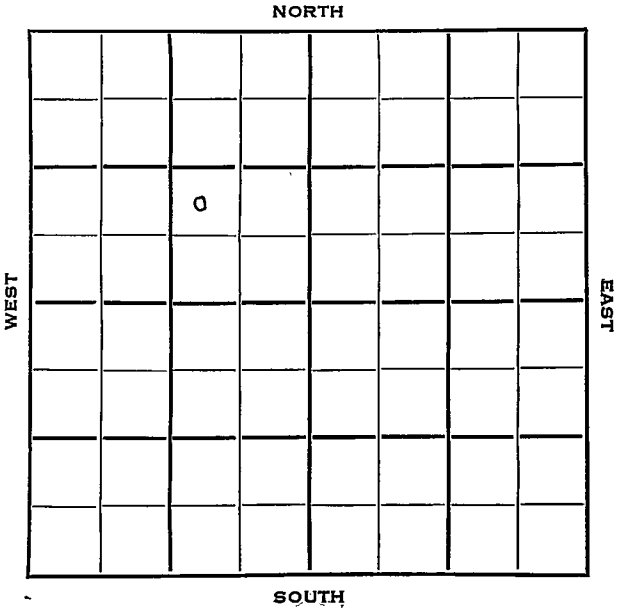

Sec. 36 Twp. 24 R. 14W

Well No. #3 Kachelman Farm

Westgate-Greenland Company

W-G Contractor
SE Koelsch Pool


 Ft. from N. Line

990 Ft. from S. Line

990 Ft. from E. Line

 Ft. from W. Line

NW SE NW

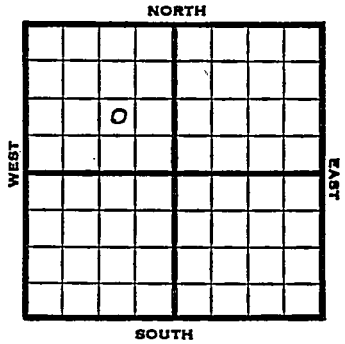

1953

Elev. 1947' REPORT

4/1

Spud 3-28-53
8" @ 205
Drlg. 2220'

4/9

Drlg. 3884'

4/16

Pipe set.

4/23

NR

4/29

Spud 3-28-53 Oil well TD 4216
8" @ 205 anhy 843' Heeb 3443
Lans. 3614
DST 3648-88 open 1 hr rec 235' SW
1220#
DST 3688-3726 open 1 hr, rec 375' SW
1200# B KC 3882 Viola 4002
Simp 4147 Simp. sd. 4161'
DST 4163-72 open ,1 hr. rec 210' gas,
90' O & GCM 1300#
Arb. 4188'
DST 4190-4203 open 1 hr rec 550' gas
585' clean oil, 1385#
DST 4203-13 open 1 hr, rec 3975' oil
1440# TD 4216 5" @ 4216
118/4190-4212 FU 3800' oil 3 hrs.
S/70 BO 3 hrs.
Comp. 2482 BOPD 12% wtr.

COMPLETED

