

Stafford

KANSAS

SECTION 36 TOWNSHIP 24 RANGE 15W

WELL NO. #2 Satterlee

COMPANY Wilcox, Henry, Durbin, Bond, & Lewis

NORTH

	0						

WEST

EAST

SOUTH

Stafford

KANSAS

SEC.	TWP.	R.
36	24	15W

WELL NO.

#2 Satterlee

FARM

COMPANY

Wilcox, Henry, Durgin-Bond & Lewis

CONTRACTOR

~~###~~ Lewis

NE Farmington


Ft. from N. Line

Ft. from S. Line

Ft. from E. Line

Ft. from W. Line

SE NW NW

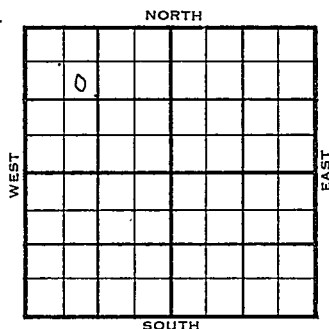

1956

ELEVATION

2010'

REPORT

4-25

Comm. 4-21-56

8" @ 200 w/175

Drlg. 2300

Anh. 940

5-16

Pipe stuck @ 3355

(Lost circ., lost 4 Drill Collors)

Came out ~~at~~ o & hole blew out gas est
5 mill. CF, no samples taken.

D & A

(To move 300' North later.)

Anh. 940'

TD 3455'

ABANDONED

County Stafford Elev. _____
Sec. 36 Twp. 24 Rge. 15W
Company Wilcox, Henry, Durbin-Bond & Lewis
Farm Name Satterlee No. 2

TOPS	DEPTH	LOG	DATUM	Loc. in Sec.
Anb.	940			SE NW NW
Tp.				
H.				
Tr.				
Dg.				
Bl.				
L.				
K.C.				Geol. _____
B.K.C.				Contr. _____
Ce.				Lewis
C.				
M.				
M.				Pool _____
K.				NE Farmington
Mz.				
Mq.				
V.				
S.				
S.				
A.				
R.				
Pe.				
G.				
T.D.				

FIRST REPORT

APR 25 '56

Date Comm. 4-21-56
8" @ 200/175 drlg. 2300

[Handwritten signature]

S. YAM

K. G.

County Stafford Elev. 2010
 Sec. 36 Twp. 24 Rge. 15W
 Company Wilcox, Henry, Durbin-Bond & Lewis
 Farm Name Satterlee No. 2

TOPS	DEPTH	LOG	DATUM	Loc. in Sec.
Anb.	910			SE NW NW
TP.				
H.				
Tr.				
Dg.				
Bl.				
L.				Mayfield
K.C.				Geol.
B.K.C.				Contr.
Ce.				Lewis #4
C.				
M.				
M.				
K.				Pool
Mz.				NE Farmington
Mq.				
V.				
S.				
S.				
A.				
R.				
PE.				
G.				ABANDONED
TD.	3455			

Date Comm. 4-21-56 MAY 16 1956

8" @ 200/175 drlg. 2300 MAY 2 '56 3357

Lossing circ. MAY 9 '56 PTD 3439

Pipe stuck @ 3355 MAY 15 '56 X to
 3455 TD (Lost circ. Lost 4 Drill
 collars) came out of hole Blew out
 gas est 5 Mill. CF no samples
 taken.

DEA

To Move 300' North later.