


SECTION 36 TOWNSHIP 24 RANGE 15W

WELL NO. #2 Satterlee "A"

COMPANY Petroleum Management

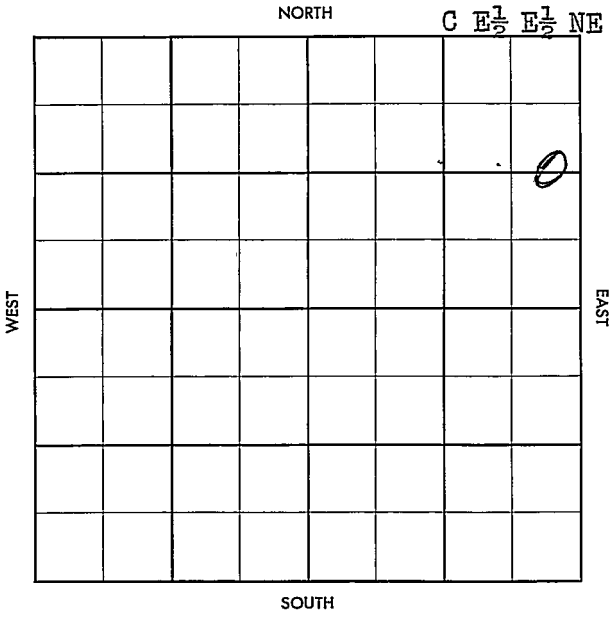

2004 OF

County Stafford Elev. 2007 RB
 Sec. 36 Twp. 24 Rge. 15W
 Company Petroleum Management
 Farm Name Satterlee "A" No. 2

TOPS	DEPTH	LOG	DATUM	Loc. in Sec.
Anb.	935			C 7 ¹ E ¹ NE
Tr.				
H.	3588			
Tr.				
Dg.				
Bl.				
L.	3750			Geol.
K.C.				Contr.
B.K.C.	3996			Transit <u>43</u>
Ce.				
C.				
M. <u>chert</u>	4150			Pool
M.				<u>Satterlee</u>
K.	4182			
Mz.				
Me.				
V.	4242			
S.	4322			
S.				
A.	4411			
R.				
Pe.				
G.				
T.D.	4497			

OCT 2 '57
ABANDONED

Date Comm.

Location JUL 10 '57 7-4-57 85/8

244/200 @ 2740

@ 4162 " " DST 4114-90 1hr.

35' M BHPO 5 1/2 4462/125

WOCT ✓ 1 1/2 4462/125 WOCT

SEP 25 '57 SEP 4 '57 SEP 11 '57 SEP 18 '57

SEP 25 '57 OCT 2 '57 X art buckle open

hole 4462 - 4497

To be SWP