


Section 36 Township 21 Range 15W

Well No. #1 Thurow

Company Harry Koplín

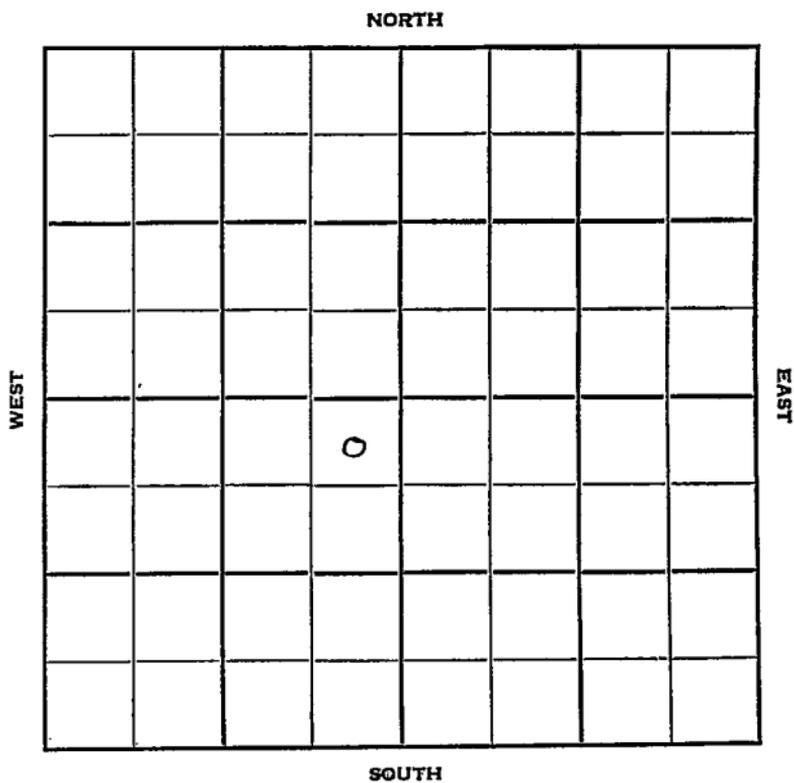

Sec. 36 Twp. 24 R. 15 W ✓

Well No. # 1 Thurow Farm

Harry Koplin Company


Berwick Contractor

330 Ft. from N. Line

_____ Ft. from S. Line

330 Ft. from E. Line

_____ Ft. from W. Line

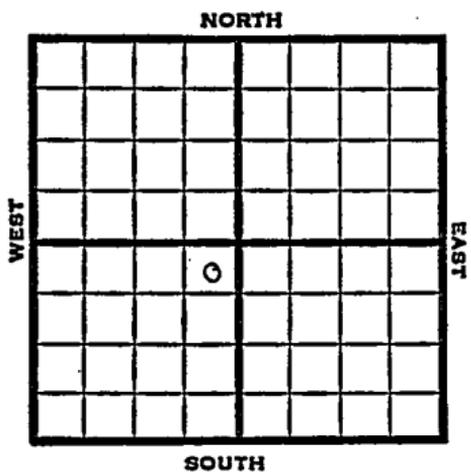

NE NE SW

Stanolind Farmout
Sinclair DHM

1951 Elev. 2009' REPORT

8/29 Spud 7-30-51
8" @ 271'
Drlg. 3510'

9/5 Spud 7-30-51
D&A TD 4470
8" @ 271
Heeb. 3599 KC 3784 B KC 4052
Miss 4185 KH 4221 Viola 4280
Simp. 4388 Simp. sd. 4405-18
Arb. 4434 TD 4470
D&A

ABANDONED

County **Stafford** State **Kansas**

Sec. **36** (Blk. Twp.) **24** (Sur. Rge.) **15W** Map No.

Operator **Harry Koplin**

Well No. **1** Farm **Thurrow**

Elev. Location **NE NE SW**

FIRST REPORT					

330 Ft. From **N** Line **SW**

330 Ft. From **E** Line Quarter

Ist. Report **AUG 29 1951**

Completion

Remarks **Stanford farmout
Sinclair DM**

Berwick - Contr.

Spudding Date **7-30-51**

Drig. Data **Wildcat**

8" @ 271 drig. 3510

J. E. TYRA

