

KANSAS


FORM 51 5M BR1X

Finney County

Section 36 Township 24 Range 34W

Well No. #4 Layman

Company Kansas Neb. Nat. Gas

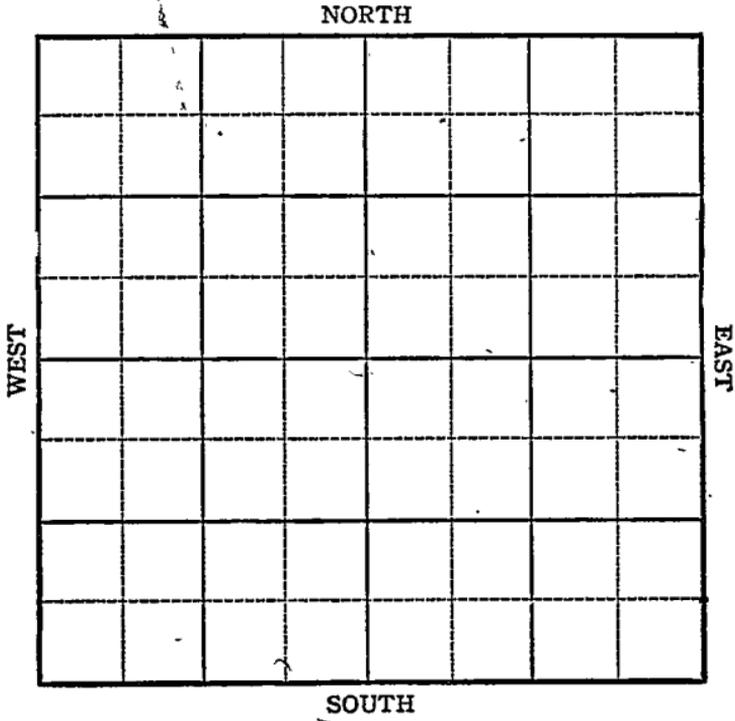

Sec. 36 Twp. 24 R. 34W

Well No. #4 Layman Farm

Kansas Neb. Nat. Gas Company


Hugoton

2640 Ft. from N. Line

_____ Ft. from S. Line

2640 Ft. from E. Line

_____ Ft. from W. Line

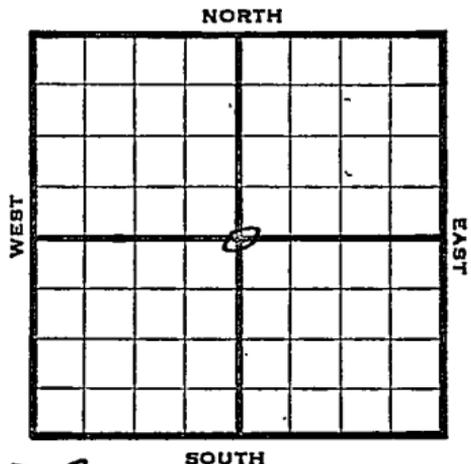

C Sec. Elev. 2939

1944 R E P O R T

10/4	Location
10/11	"
10/18	"
10/25	"
11/1	10" @ 560' Drlg. 2000
11/8	7" @ 2860 TD 2890 To perf.
11/16	" " " "
11/24	" " " " " "
11/29	" " " " " "
12/6	" " " " " "
12/14	" " " " " "
12/21	" " " " " "
12/29	" " " " " "
1945	
1/3	" " " "
1/10	" " " "
1/17	26 500 acid
1/26	" "
1/31	11 M Gas
2/7	" " "
2/14	" " "
2/21	18,600,000 gas

OVER

1945

2/28 7" @ 2860
124 Perf. 2532-2824
26,500 acid
TD 2890
18,600,000 gas

~~ABANDONED~~

COMPLETED

1951
2/7

O.W.W.O.

Gas well
TD 2530'
SP 2530' 2500 A
Comp. 2,000,000 cfcpd

FIRST REPORT

✓
COMPLETED

KANSAS Pool Name Hugoton
 Map No. W 11 Sec. 36 Twp. 24 R. 34 W
 Well No. 4 Layman

Kansas Nebraska Nat. Gas Company


FIRST REPORT

Contractor

C Sec

SECTION PLAT

2640 Ft. from N. Line
 _____ Ft. from S. Line
2640 Ft. from E. Line
 _____ Ft. from W. Line

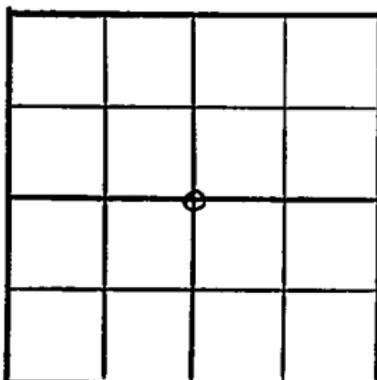

Finney

Location X
 Rig up _____
 Drilling and Remarks:

RECORD

Cased _____ in., _____ ft.
 Sand _____
 Gas _____
 Oil _____
 Total Depth _____

PRODUCTION

1st 24 hrs. Nat. _____
 1st 24 hrs. after shot _____
 Gas _____ Cu. Ft.
 Dry Hole _____
 Abandoned _____

Date

OCT 4 1944 19

S. J. LEWIS Scout

Pool Name HugotonMap No. 1111 Sec. 36 Twp. 24 R. 34WWell No. 4 LaymanKansas-Nebraska Nat. Gas CompanyCOMPLETED Contractor

C sec.


SECTION PLAT

2640 Ft. from N. Line

_____ Ft. from S. Line

2640 Ft. from E. Line

_____ Ft. from W. Line

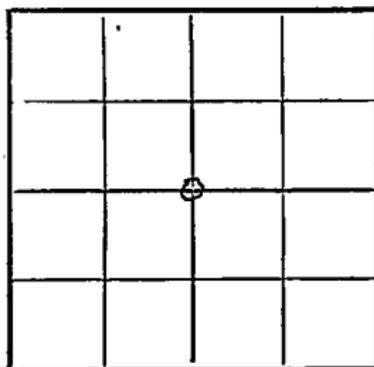Finney

Location _____

Rig up _____

Drilling and Remarks:

7" @ 2860124/2532-282426,500 bbl18,600,000 gas

RECORD

Cased _____ in., _____ ft.

Sand _____

Gas _____

Oil _____

Total Depth 2850

PRODUCTION

1st 24 hrs. Nat. _____

1st 24 hrs. after shot _____

Gas _____ Cu. Ft.

Dry Hole _____

Abandoned _____

Date

FEB 28 1945 19S. I. LEWIS Scout

County **Finney** State **Kansas**

Sec. **36** (Blk. Twp.) **24** (Sur. Rge.) **34W** Map No.

Operator **Kansas - Nebraska**

Well No. **4** Farm **Leyman**

Elev. **2939** Location **C Sec.**

FIRST REPORT O COMPLETE				2640 Ft. From N Line	Sec.
				2640 Ft. From W Line	Quarter
1st. Report		FEB 7 1951			
Completion		FEB 7 1951			
Remarks		O.W.N.O.			
Spudding Date					
Drlg. Data		Gas well TD 2530			
SP 2530	2500 A	Comp. 2,000,000 cf/gpd			

2640 Ft. From N Line Sec.

2640 Ft. From W Line Quarter

1st. Report FEB 7 1951

Completion FEB 7 1951

Remarks O.W.N.O.

Spudding Date

Drlg. Data Gas well TD 2530

SP 2530 2500 A Comp. 2,000,000 cf/gpd