


KANSAS

Kearny County

Section 21 Township 24 Range 37W

Well No. #8 Strat

Company Stanolind

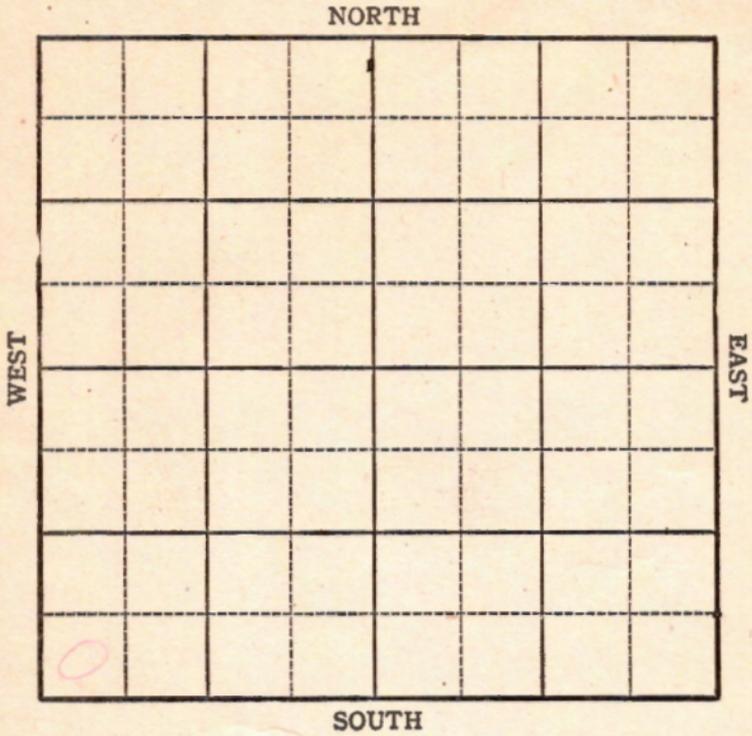

Sec. 21 Twp. 24 R. 37W

Well No. #8 Strat Farm _____

Stanolind Company _____


Wildcat

_____ Ft. from N. Line

330 Ft. from S. Line

_____ Ft. from E. Line

330 Ft. from W. Line

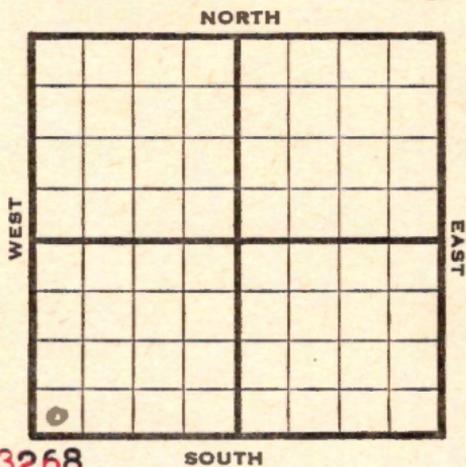

SW/c Elev. 3268

1945

R E P O R T

1/17

- Blaine 1260 ?
- Anhy 2035
- Herrington 2573
- Krider 2608
- Winefield 2657
- Ft Riley 2718
- D & A TD 2821

FIRST REPORT

&

ABANDONED

KANSAS

Pool Name Wildcat

Map No. _____ Sec. 21 Twp. 24 R. 37 W

Well No. 8Strat

Starolind Company

FIRST REPORT and
ABANDONED E.L. 3268 Contractor

SW/c


SECTION PLAT

_____ Ft. from N. Line

330 Ft. from S. Line

_____ Ft. from E. Line

330 Ft. from W. Line

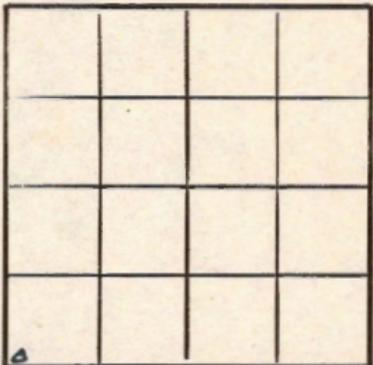

Kearny

Location _____

Rig up _____

Drilling and Remarks:

Blaine 1260?
Anhy 2035
Herrington 2573
Krider 2608
Winefield 2657
Ft. Riley 2718
D & A

RECORD

Cased _____ in., _____ ft.

Sand _____

Gas _____

Oil _____

Total Depth 2821

PRODUCTION

1st 24 hrs. Nat. _____

1st 24 hrs. after shot _____

Gas _____ Cu. Ft.

Dry Hole _____

Abandoned _____

Date

JAN 17 1945 19

S. J. LEWIS Scout