


FORM 51 25M 3-49 PETROL Kearny

Section 5 Township 24 Range 37WWell No. #1 J.B. GraberCompany Kuhn Drlg.

NORTH

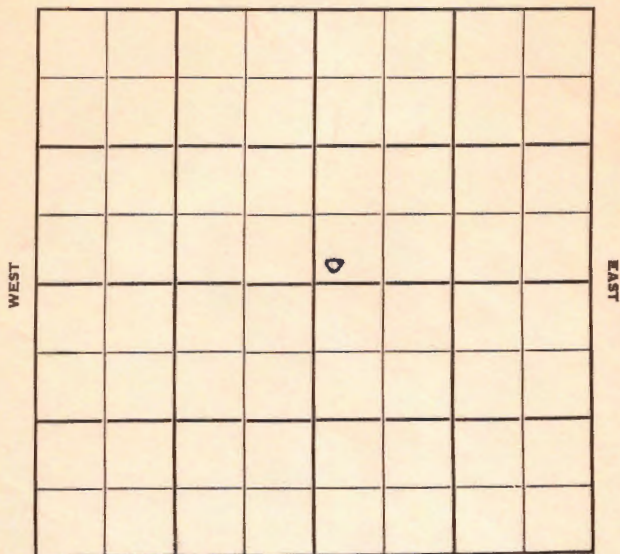

SOUTH

Kearny

KANSAS

Sec. 5 Twp. 24 R. 37WWell No. #1 J. B. Graber Farm

Kuhn Drlg.

Company

Hugoton Pool

Contractor

Ft. from N. Line

100

Ft. from S. Line


Ft. from E. Line

100

Ft. from W. Line

NE $\frac{1}{4}$

SW NE

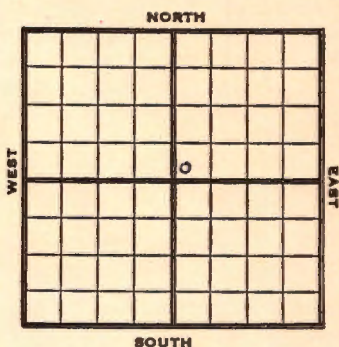

1952

Elev. 3287

REPORT

11/12

Spud 11-8-52
10" @ 320'

11/20

RTD 2587' 7" @ 2569'

11/27

NR

12/4

"

12/11

NR

12/18

DD 2642 TD

12/25

" " "

1/1

NR

1/8

TD 2780 4000A

1/22

NR

1/29

NR

2/5

"

2/12

"

2/19

22,000A

231' of 5" liner

Her 2572, Kr 2600, Win 2634, Up
Ft. 2694, Low? Ft. 2734

OVER

1953

2/26 N.R.

3/12 "

3/19 NR

3/25 Spud 11-8-52

Gas Well

TD 2780

10" @ 320

Her 2572, Kri 2600, Win 2634, Ft.

Riley 2734

7" @ 2569

TD 2780

4000 A Comp. 581,000 gas

COMPLETED

County **Kearny** State **Kansas**
 Sec. **5** (Blk.) **24** (Sur.) **37W** Map No.

Sec. 5 (Blk.) 24 (Sur.) 37W Map No.

Operator John Drlc.

Well No. 1 Farm J. B. Graber

Elev.	Location	SW	NE
-------	----------	----	----

100 Ft. From S Line NE

100 Ft. From W Line Quarter

1st. Report NOV 1 2 1952

Completion

Remarks

Spudding Date 11-8-52

Drig. Data	Hugoton Pool

10th • 320

J. G. McGEHEE

County Kearny State Kansas

Sec. 5 (Blk. Twp.) 24 (Sur. Rge.) 37W Map No.

Operator Kuhn Drlg.

Well No. 1 Farm J. B. Graber

Elev. 3287 Location SW NE

0

COMPLETE

100 Ft. From S Line NE

100 Ft. From W Line Quarter

1st. Report

Completion MAR 25 1953

Remarks	Hugoton Pool
---------	--------------

Spudding Date 11-8-52

Drilg. Data Gas well TD 2780

10" @ 320 Her. 2572 Kri. 2600

Win. 2634 Ft. Riley 2734 7" @ 2569

TD 2780 4000 A Comp. 581,000 gas