


Section 6 Township 24 Range 37W

Well No. #1 Villines BEYMER

Company E. W. Campbell etal.

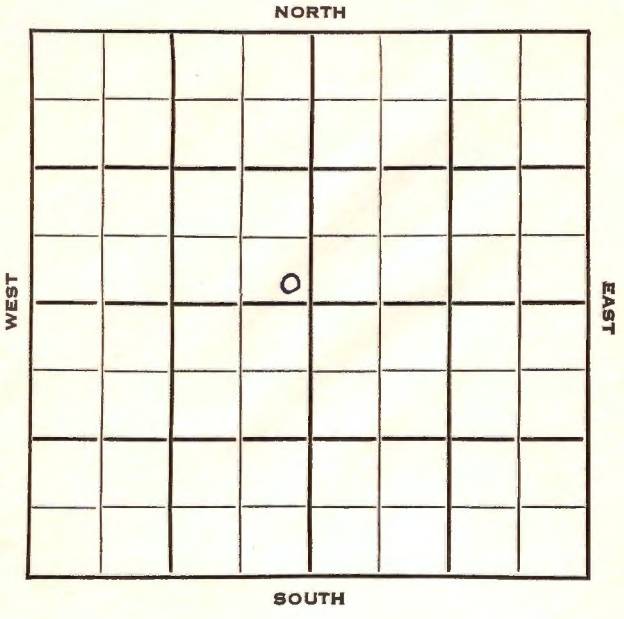

Kearny

KANSAS ✓

Sec. 6 Twp. 24 R. 37W

Well No. #1 Villines #1 BEYMER Farm

E. W. Campbell et al Company

Contractor

Hugoton Pool


 Ft. from N. Line

100 Ft. from S. Line

100 Ft. from E. Line

 Ft. from W. Line

SE NW

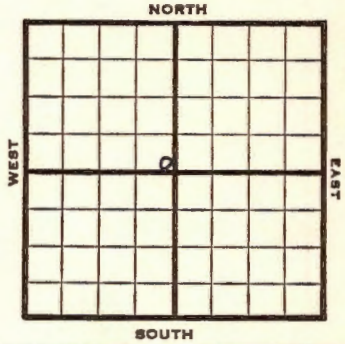

1953

Elev. 3310'

REPORT

4/29

Location

5/7

"

5/21

"

5/28

8" @ 350
Drlg. 1200'

6/3

TD-2585' 5" @ 2585

6/10

Her-Kri 2583-2613'

6/24

Spud 5-25-53
Gas Well
TD 2786
8" @ 350

**Her-Kri 2583, Win 2635, Ft. Riley
2685'**

3000 frac, 500A
TD 2786, 16,000A
Comp. 4 mcfgpd

COMPLETED

Map No. _____ Sec. 6 Twp. 24 R. 37W

Well No. 1 Beymer

E. W. Campbell et al. Company

CORRECTION

Contractor

SE NW

SECTION PLAT

_____ Ft. from N. Line

100 Ft. from S. Line

100 Ft. from E. Line

_____ Ft. from W. Line

Kearny County

Location _____

Rig up _____

Drilling and Remarks:

Reported
#1 Villines

RECORD

Cased _____ in., _____ ft.

Sand _____

Gas _____

Oil _____

Total Depth _____

PRODUCTION

1st 24 hrs. Nat. _____

1st 24 hrs. after shot _____

Gas _____ Cu. Ft.

Dry Hole _____

Abandoned _____

Date

JUN 3 1953 19

I. G. McGEHEE Scout

