


FORM 51 Kearny

KANSAS

Section 9 Township 24 Range 37W

Well No. 1 Kropp

Company Walt Kuhn Drlg.

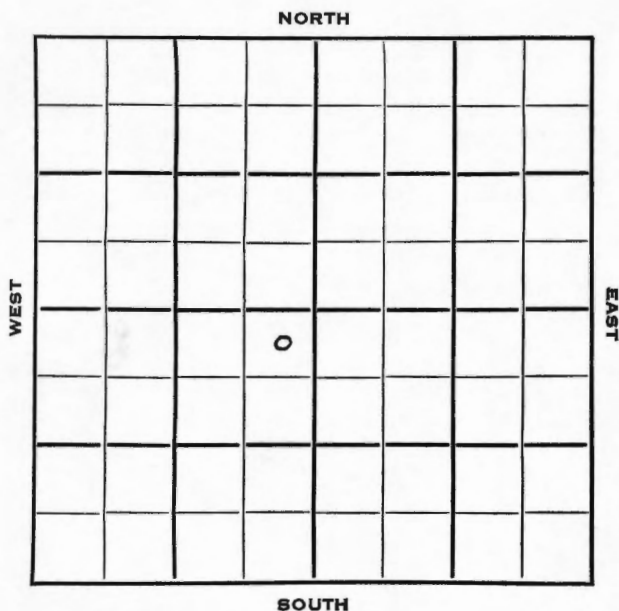

Sec. 9 Twp. 24 R. 37WWell No. 1 Kropp FarmWalt Kuhn Drlg. Company

Contractor


100 Ft. from N. Line

Ft. from S. Line

Ft. from E. Line

100 Ft. from W. Line

NE SW

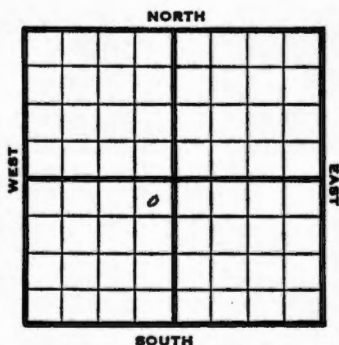

1952

Elev. 3262'

REPORT

12/30 Location

1/1 10" Coring 307

1/8 RTD 2551 7" @ 2504

1/22 NR

1/29 NR

2/5 "

2/12 Hol 2528, Her 2545, Kr 2580

2/19 DD 2745 ^{TU} 233' of 5" liner
 Win 2607, Up Ft. 2666, Low
 Ft. 2706
 16,250A

2/26 N.R.

3/12 "

3/18 Spud 12-21-52 Gas well TD 2745'
 10" @ 307 TD 2551 7" @ 2548
 Hol. 2528' Her. 2545 Kri 2580
 DD 2745 Win 2607 Ft. Riley 2666
 20,500 A
 Comp. 1,212,000 gas.

COMPLETED

