


Section 12 Township 24 Range 37WWell No. #1 GreeneCompany Sinclair

NORTH

WEST

EAST

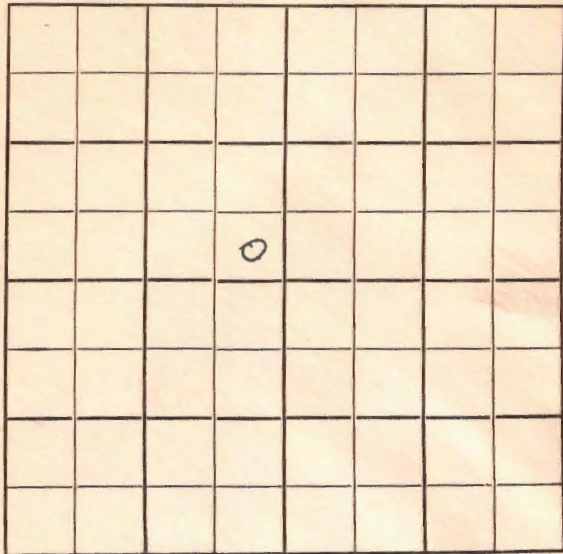

SOUTH

KANSAS

Kearny

Sec. 12 Twp. 24 R. 37 ^W

Well No. #1 Greene Farm

Sinclair Company

Hugoton Contractor


 Ft. from N. Line

330 Ft. from S. Line

330 Ft. from E. Line

 Ft. from W. Line

SE SE NW

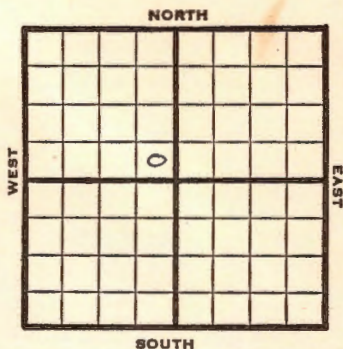

1950

Elev 3244

REPORT

8/30 Spud 8-27-50
10 3/4" @ 683

WOC

9/27 10 3/4" @ 683
7" @ 2769
TD 2770

Hol 2498-2506

Her 2524-62

Win 2582-2608

Towanda 2638-66

Ft. Riley 2604-2727

246/2684-2727 6000 A 167/2638-66

9000 A

138/2585-2608

5000 A

228/2524-2562

6000 A

66/2489-2503

5000 A

Comp 14,190,000 gas open flow

TD 2770

Completed

COMPLETED

J. E. TYRA

County Kearny State KansasSec. 12 (Blk.
Twp.) 24 (Sur.
Rge.) 37W Map No.Operator SinclairWell No. 1 Farm GreeneElev. 3244 Location SE SE NW

		0			

COMPLETE

330 Ft. From S Line NE330 Ft. From E Line Quarter

1st. Report

Completion SEP 27 1950Remarks Hugoton PoolSpudding Date 8-27-50Drilg. Data Gas well TD 277010 3/4" @ 683 7" @ 2769. TD 2770Hol. 2498-2506 Her. 2524-62 Win. 2582-26082608 Towanda 2638-66 Ft. Riley 2684-2727246/ 2684-2727 6000 A 167/ 2638-669000 A 138/ 2585-2608 5000 A 228/ 25242562 6000 A 66/ 2489-2503 5000 AComp. 14,190,000 gas open flow

J. E. TYRA