

KANSAS

FORM 51 IOM 12-46 PETROL

Section 15 Township 24 Range 37-N

Well No. #1 Dotson


Company Stanolind

Hugoton

NORTH

WEST

EAST

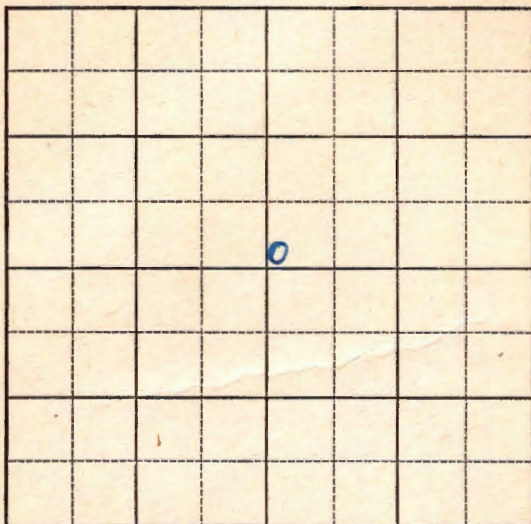

SOUTH

KANSAS

Kearny County

Sec. 15 Twp. 24 R. 37-WWell No. 1 Dotson FarmStanolind

Company

Hugoton Pool

Ft. from N. Line

50


Ft. from S. Line

Ft. from E. Line

50

Ft. from W. Line

SW NE

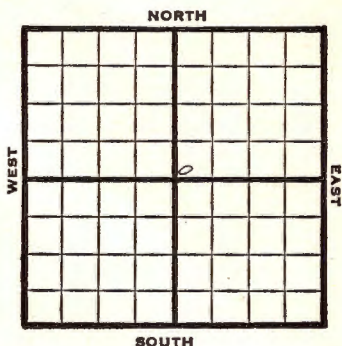

1947

Elev. 3252' REPORT

8/20

Drlg. 600'

8/27

8" @ 765'

Drlg. 2538'

9/3

"

9/10

5" @ 2754'

3000 acid

96 shots 2712-28

2500 Acid

9/17

42 shots. 2646-52'

84 shots. 2658-72' - 2500 acid

144 shots. 2601-25 - 3500 acid SW PB

9/24

PB 2739'

10/1

PB 2749' - 10,000 acid

SW

10/8

5" @ 2754'

Perf.

22,000 Acid

2,214,000 Gas

TD 2801'

390# R Pr.

COMPLETED

Map No. _____ Sec. 15 Twp. 24 R. 37W

Well No. 1 Dotson

Stanolind Company

FIRST REPORT Contractor

SW NE


SECTION PLAT

_____ Ft. from N. Line

50 Ft. from S. Line

_____ Ft. from E. Line

50 Ft. from W. Line

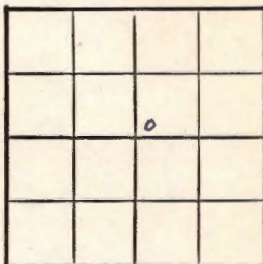

Kearny County

Location _____

Rig up _____

Drilling and Remarks:

drlg. 600

RECORD

Cased _____ in., _____ ft.

Sand _____

Gas _____

Oil _____

Total Depth _____

PRODUCTION

1st 24 hrs. Nat. _____

1st 24 hrs. after shot _____

Gas _____ Cu. Ft.

Dry Hole _____

Abandoned _____

Date

AUG 20 1947 19 S. J. LEWIS Scout

Map No. 0 Sec. 15 Twp. 24 R. 37W

Well No. 1 Dotson

Stanolind Company

COMPLETE Contractor

SW NE

E18252
SECTION PLAT

50 Ft. from N. Line

50 Ft. from S. Line

50 Ft. from E. Line

50 Ft. from W. Line

		0	

Kearny County

Location _____

Rig up _____

Drilling and Remarks:

5" @ 2754

Perf.

22000 acid

2,214,000 Gas

390 R/P

RECORD

Cased _____ in., _____ ft.

Sand _____

Gas _____

Oil _____

Total Depth 2801

PRODUCTION

1st 24 hrs. Nat. _____

1st 24 hrs. after shot _____

Gas _____ Cu. Ft.

Dry Hole _____

Abandoned _____

Date

OCT 8 1947

19

S. J. LEWIS Scout