

Section 18 Township 24 Range 37WWell No. #1 M. GraberCompany Kansas-Nebraska

NORTH

WEST								EAST

SOUTH

Kearny

KANSAS

Sec. 18 Twp. 24 R. 37W

Well No. #1 M. Graber Farm

Kansas-Nebraska Company

Contractor


150' Ft. from N. Line

Ft. from S. Line

Ft. from E. Line

150' Ft. from W. Line

NW SE

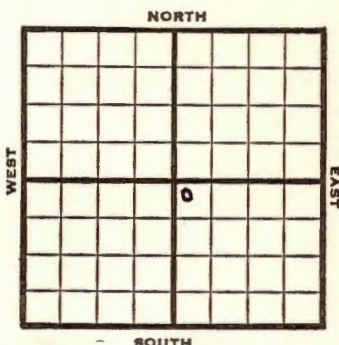

1952 Elev. 3289' REPORT

7/23 Spud 7-20-52
10" @ 365
WOC

7/30 TD 2785'
7" @ 2275'

8/6 " " "

8/13 NR

8/20 "

8/27 "

9/3 CO 2765 132/2570-92 84/2626-40
72/2678-90 204/2716-50 20,000 A
Her. 2576 Winfield 2628
Up Ft 2684 Low Ft 2726

9/10 28,000 Total A

9/17 NR

9/24 "

10/1 "

10/8 Spud 7-20-52 Gas well TD 2785'
10" @ 365 7" @ 2775 TD 2785'
CO to 2765 132/2570-92 84/2626-40
72/2678-90 204/2716-50 Her. 2570'
Win. 2628' Ft. Riley 2684'
28,000 A
Comp. 8,016,000 gas

COMPLETED

County **Kearny** State **Kansas**Sec. **18** (Blk.) **24** (Sur.) **37W** Map No.
(Twp.) (Rge.)Operator **Kansas-Nebraska**Well No. **1** Farm **M. Graber**Elev. Location **NW SE**

FIRST REPORT

150 Ft. From **N** Line **SE****150** Ft. From **W** Line Quarter1st. Report **JUL 23 1952**

Completion

Remarks

Spudding Date **7-20-52**Drlg. Data **MCPC has sec. 29-24-37 & block 1 mile**
10" @ 365 WOC **SW**

