

Section 24 Township 24 Range 37-W

Well No. #1 Wheeler

Company Stanolind

NORTH

				0			

WEST

EAST

SOUTH

Sec. 24 Twp. 24 R. 37-W

Well No. #1 Wheeler Farm

Stanolind Company

Contractor

Hugoton


Ft. from N. Line

150 Ft. from S. Line

Ft. from E. Line

150 Ft. from W. Line

SW NE

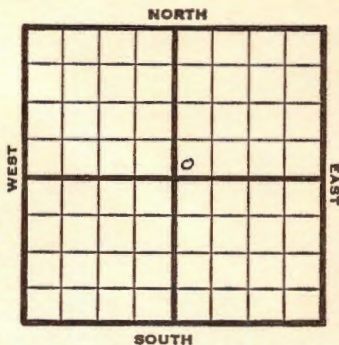

1950

**Elev 3176**

REPORT

8/2 Location

9/6 Spud 8-1-50

10" @ 65

5" @ 2636

TD 2675

Win 2528-54

Towanda 2582-2609

Ft. Riley 2645 216/2472-2508, 156/2528-54 162/2582-2609

31500 total acid

Comp 7,662,000 418#

Completed

**COMPLETED**

Map No. \_\_\_\_\_ Sec. 24 Twp. 24 R. 37WWell No. 1 WheelerStanolind Company

Contractor \_\_\_\_\_

SW NE

## SECTION PLAT

		o	

FIRST REPORT

\_\_\_\_\_ Ft. from N. Line

150 Ft. from S. Line

\_\_\_\_\_ Ft. from E. Line

150 Ft. from W. LineKearny CountyLocation X

Rig up \_\_\_\_\_

Drilling and Remarks:

## RECORD

Cased \_\_\_\_\_ in., \_\_\_\_\_ ft.

Sand \_\_\_\_\_

Gas \_\_\_\_\_

Oil \_\_\_\_\_

Total Depth \_\_\_\_\_

## PRODUCTION

1st 24 hrs. Nat. \_\_\_\_\_

1st 24 hrs. after shot \_\_\_\_\_

Gas \_\_\_\_\_ Cu. Ft.

Dry Hole \_\_\_\_\_

Abandoned \_\_\_\_\_

Date

AUG 2 1950 19J. E. TYRA Scout

