

Kearny

KANSAS  
37W

Section 19 Township 24 Range \_\_\_\_\_

Well No. #1 McCormick

Company W.E. Bakke

NORTH

				0			

WEST

EAST

SOUTH

Sec. **19** Twp. **24** R. \_\_\_\_\_

Well No. **#1 McCormick** Farm \_\_\_\_\_

**W.E. Bakke** Company \_\_\_\_\_

Contractor \_\_\_\_\_


\_\_\_\_\_ Ft. from N. Line

**100** Ft. from S. Line

\_\_\_\_\_ Ft. from E. Line

**100** Ft. from W. Line

**SW NE**

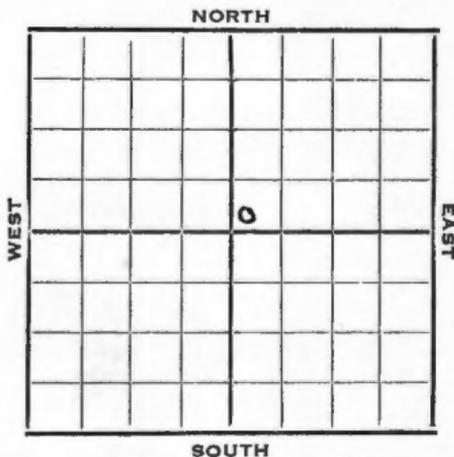

**1952**

**Elev. 3262' REPORT**

**8/27 Location**

**9/3 8" @ 357  
Drlg. 1325'**

**9/10 RTD 2585 5" @ 2550 Her. 2549**

**9/17 NR**

**9/24 DD 2745**

**10/1 Winfield 2597 Up Ft. 2670**

**Low Ft 2708**

**DD 2773' TD PB 2682**

**21,000 A**

**10/8 "**

**10/15 "**

**10/22 Gas well TD 2773' 8" @ 357  
Her. 2549' Win. 2597' Ft. Riley ~~2549~~  
2670' 5" @ 2550 TD 2773'  
PB 2682' 21,000 A  
Comp. 2,820,000 gas 380#**

**COMPLETED**



