

Section 28 Township 24 Range 37-W

Well No. #1 Hefner Unit

Company Sinclair O & G etal

NORTH

|  |  |  |  |   |  |  |  |
|--|--|--|--|---|--|--|--|
|  |  |  |  |   |  |  |  |
|  |  |  |  |   |  |  |  |
|  |  |  |  |   |  |  |  |
|  |  |  |  | 0 |  |  |  |
|  |  |  |  |   |  |  |  |
|  |  |  |  |   |  |  |  |
|  |  |  |  |   |  |  |  |
|  |  |  |  |   |  |  |  |

WEST

EAST

SOUTH

Sec. 28 Twp. 24 R. 37-W ✓

Well No. #1 Hefner Unit Farm

Sinclair Oil & Gas ET al Company

Contractor

Hugoton


Ft. from N. Line

330 Ft. from S. Line

Ft. from E. Line

330 Ft. from W. Line

SW SW NE

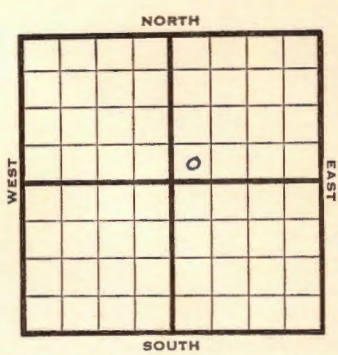

1950 **Elev 3273** REPORT

7/19 Location

9/27 8" @ 693  
 Hol 2525-35 Her 2548-71  
 Krider 2571-92 Win 2612-40  
 Towanda 2678-96 Ft. Riley 2720-62  
 TD 2819  
 5" @ 2817  
 252/2720-62  
 1000 A 163/2668-96 9000 A  
 190/2609-41 5000 A  
 220/2552-89 6000 A  
 60/2522-32 5000 A  
 Comp 11,765,000 gas open flow  
 TD 2819  
 Completed

**COMPLETED**

Kansas

Map No. \_\_\_\_\_ Sec. 28 Twp. 24 R. 37W

Well No. 1 Hefner Unit

Sinclair Oil & Gas etal. Company

Contractor \_\_\_\_\_

SW SW NE

*Mid-Cont all sec 29*

SECTION PLAT

\_\_\_\_\_ Ft. from N. Line

330 Ft. from S. Line

\_\_\_\_\_ Ft. from E. Line *29*

330 Ft. from W. Line



Kearny County

Location X

Rig up \_\_\_\_\_

Drilling and Remarks:

RECORD

Cased \_\_\_\_\_ in., \_\_\_\_\_ ft.

Sand \_\_\_\_\_

Gas \_\_\_\_\_

Oil \_\_\_\_\_

Total Depth \_\_\_\_\_

PRODUCTION

1st 24 hrs. Nat. \_\_\_\_\_

1st 24 hrs. after shot \_\_\_\_\_

Gas \_\_\_\_\_ Cu. Ft.

Dry Hole \_\_\_\_\_

Abandoned \_\_\_\_\_

Date

JUL 19 1950

19

J. E. TYRA

Scout

