

KANSAS


Kearny

FORM 51 10M 12-46 PETROL

Section 35 Township 24 Range 37W

Well No. 1 Smith

Company Stanolind

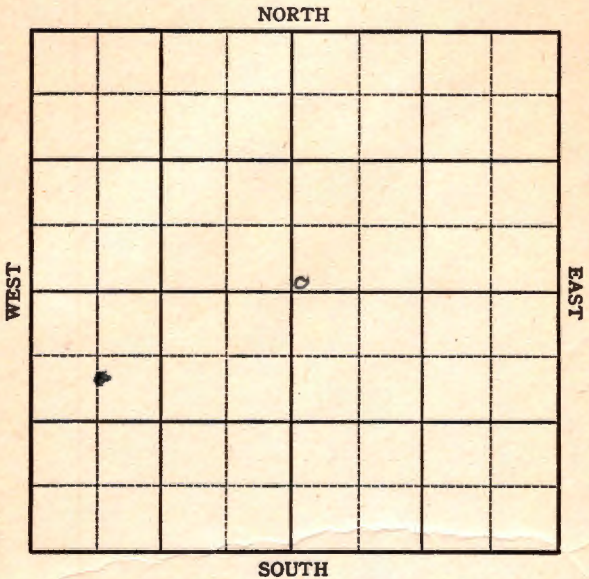

Kearny

✓

KANSAS

Sec. 35 Twp. 24 R. 37W

Well No. 1 Smith Farm
Stanolind Company


 Ft. from N. Line

50 Ft. from S. Line

 Ft. from E. Line

50 Ft. from W. Line

SW NE

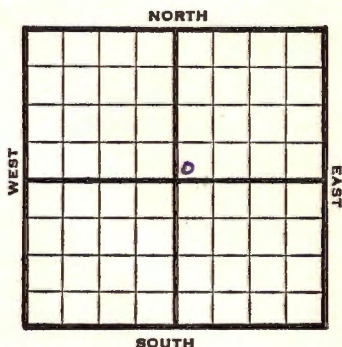

1947 **Elev. 3240'** REPORT

6/4 Drlg. 715

6/10 8" @ 760'
TD 2790'
5" @ 2754'
RUST

6/17 72 shots 2742-54 3000 Acid
126 shots 2694-2715 3000 Acid.

6/25 TD 2790'
5" @ 2754'
Perf.
13500 Acid
3,531,000 Gas
390# R. Pr.
Complete

COMPLETED

Map No. _____ Sec. 35 Twp. 24 R. 37W

Well No. 1 Smith

Stanolind Company

FIRST REPORT Contractor

SW NE

SECTION PLAT

_____ Ft. from N. Line

50 Ft. from S. Line

_____ Ft. from E. Line

50 Ft. from W. Line

		0	

Kearny County

Location _____

Rig up _____

Drilling and Remarks:

drlg. 715

RECORD

Cased _____ in., _____ ft.

Sand _____

Gas _____

Oil _____

Total Depth _____

PRODUCTION

1st 24 hrs. Nat. _____

1st 24 hrs. after shot _____

Gas _____ Cu. Ft.

Dry Hole _____

Abandoned _____

Date

JUN 4 1947

19

S. J. LEWIS

Scout

Map No. 0 Sec. 35 Twp. 24 R. 37W

Well No. 1 Smith

Stanolind Company

COMPLETE

Contractor

SW NE


E. 32 40
SECTION PLAT

 Ft. from N. Line

50 Ft. from S. Line

 Ft. from E. Line

50 Ft. from W. Line

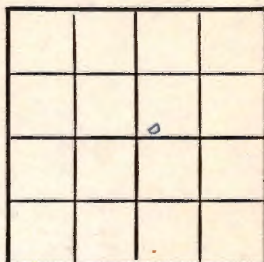

Kearny County

Location

Rig up

Drilling and Remarks:

5' @ 2754

Perf

13500 acid

8,531,000 gal

290 # R/B

RECORD

Cased in., ft.

Sand

Gas

Oil

Total Depth 2780

PRODUCTION

1st 24 hrs. Nat.

1st 24 hrs. after shot

Gas Cu. Ft.

Dry Hole

Abandoned

Date

JUN 25 1947 19

S. J. LEWIS

Scout