

DRILLING WELL COMPLETION REPORT

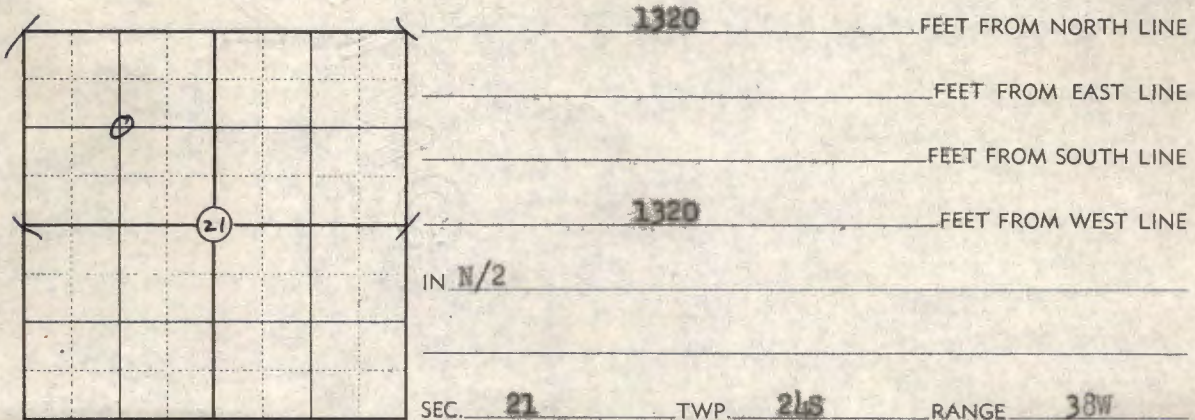
Well No. 1 Farm Name Swank UnitDate completed June 1, 1954Description N/2 Sec. 21 & N/2 Sec. 20-21S-38WCounty Kearny State KansasInitial production _____ bbls. Total depth 2654' P.B. to 2580 feetInitial volume 7,500,000 cu. ft. _____ lbs. rock pressureM.C.P.C. Interest 3/32Remarks: Operated by W. E. Bakke Oil Co.A. E. Pierce
W

Mr. McDowell
Accounting Dept.
Scouting Dept.
Geological Dept.
Pipe Line Dept.
Materials Dept.
Rental Dept.
Legal Dept.
Mr. Leo Meyer
Income Tax Dept.
Engineering Dept.
Lease Inventory
File

LOCATION NOTICE

TULSA, OKLA., May 3, 1954WELL NO. 1 ON Swank Unit FARM

WILL BE AS FOLLOWS:

Kearny COUNTY, STATE OF KansasREMARKS: Operated by W. E. Bakke Oil Co.M. C. P. C. — 3/32Unit also includes N/2 Sec. 20.MCPC lease #17411 - L.E. Heath contributed to unit.

COPIES TO:

R. W. McDOWELL

DISTRICT SUPT.

ACCOUNTING DEPT.

☒ SCOUTING DEPT.

GEOLOGICAL DEPT.

PIPE LINE DEPT.

MATERIALS DEPT.

RENTAL DEPT.

LEGAL DEPT.

LEO MEYER

INCOME TAX DEPT.

ENGINEERING DEPT.

LEASE INVENTORY

CLAIM DEPT.

J. W. BASORE

FILE

SIGNED A. E. Pierce

W

Card Typed - mm

9