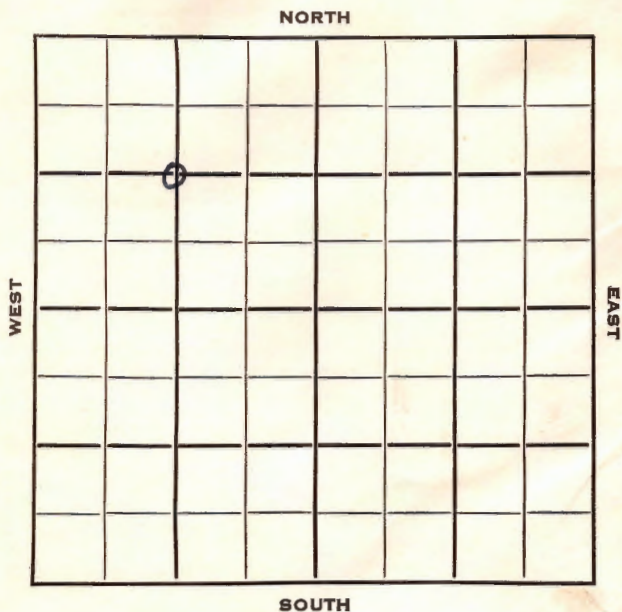


Section 21 Township 24 Range 38WWell No. 1 SwankCompany W. E. Bakke

HOT FILE

Kearny Co.

KANSAS

SEC.	TWP.	R.
21	24 S	38 W ✓

WELL NO.

1 Swank

FARM

COMPANY

W.E. Bakke -24/32% - (Operator)

CONTRACTOR

MCPC -3/32% Glen J. Smith -1/32%

John B. Hawley Jr. -4/32%

Bud Burris

Hugoton Pool

1320

Ft. from N. Line


Ft. from S. Line

Ft. from E. Line

1320

Ft. from W. Line

C NW/4

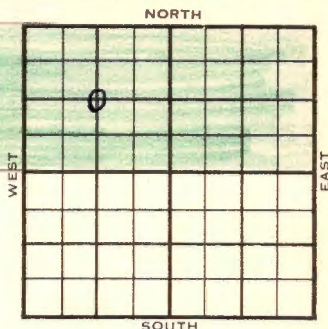

ELEVATION

REPORT

1954

3243'

5/3

Loc. Notice Hugoton Pay Zone (640 acres)

4/21

Operating Agreement Contract

5/6

Started drlg. cement at 12:00 A.M.

5/5

Spud 5-3-54. (F.R.Tkt) (Ltr-Bakke Oil)

5/7

Drlg. 1730'

5/8

Hit stone corral at 1965'

5/9

RTD 2601'. 5 1/2" @ 2585.57' w/150 sks.

5/10

WOC

(Ltr-Bakke Oil)

5/12

8" @ 256'

Hol 2460', Win 2514'

RTD 2601'

Schl

5" @ 2590'

Electric Log given Bud Conley (Geol)

5/26

5/19

WOCT.

5/26

Spud 5-3-54 Gas well TD 2654'

8" @ 256 Hol. 2460' Win. 2514'

TD 2601 5" @ 2590 DD 2654 SSG


PB 2580 40/2567-77 144/2514-38

232,000 gas. frac. Comp. 7 1/2 MCFGPD

395#

COMPLETED

County Kearny State Kansas
 Sec. 21 (Blk.) 24 (Sur.) 38W Map No.
 Operator W. E. Bakke
 Well No. 1 Farm Swank
 Elev. 3243 Location C NW/4

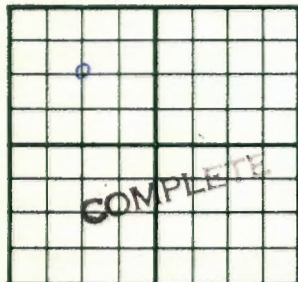

1320 Ft. From N Line NW

1320 Ft. From W Line Quarter

1st. Report

Completion MAY 26 1954

Remarks Hugoton Pool

Bud Burris - Contr.

Spudding Date 5-3-54

Drilg. Data Gas well TD 2654

8" @ 256 Hol. 2460 Win. 2514.

TD 2601 5" @ 2590 DD 2654 SSG

PB 2580 40/ 2567-77 144/ 2514-38

232,000 gas frac Comp. 7 $\frac{1}{2}$ mcf/gpd 395#

J. G. McGEHEE

J. G. McGEHEE