


Section 24 Township 24 Range 38WWell No. #1 AdamsCompany Kansas-Nebraska

NORTH

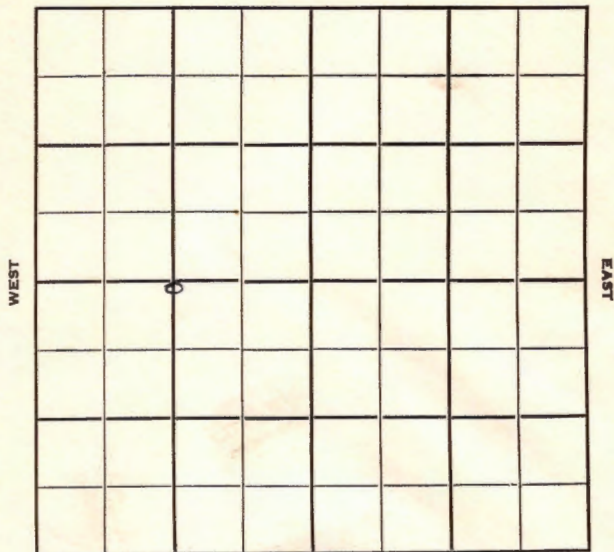

SOUTH

Kearny

KANSAS

Sec. 24 Twp. 24 R. 38W

Well No. #1 Adams Farm

Kansas-Nebraska Company

Contractor

Hugoton Pool


 Ft. from N. Line

2540' Ft. from S. Line

 Ft. from E. Line

1320' Ft. from W. Line

C N L SW/4

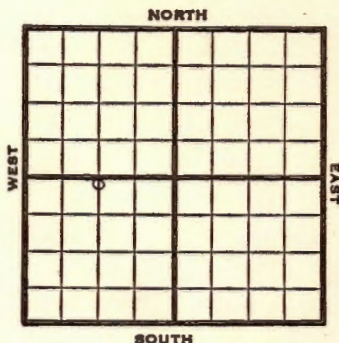

1951

Elev. 3235' REPORT

5/2

Spud 4-19-51

10" @ 800'

Drlg. 1700'

8/15

Spud 4-19-51

Gas Well TD 2730

10" @ 800 7" @ 2733

TD 2730

150/2493-2518 120/2552-72

150/2606-31 150/2653-78


Her. 2495 Win. 2556

Ft. Riley 2606 40,000 A

Comp. 911,000 gas 405#

COMPLETED

County Kearny State Kansas
 Sec. 24 (Blk. 24) (Sur. 38W) Map No.
 Operator Kansas-Nebraska
 Well No. 1 Farm Adams
 Elev. 3235 Location C N L SW/4

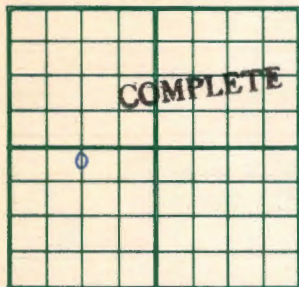

2540 Ft. From S Line SW
1320 Ft. From W Line Quarter

1st. Report

Completion AUG 15 1951

Remarks Hugoton Pool

Spudding Date 4-19-51

Drilg. Data Gas well TD 2730
10" @ 800 7" @ 2733 TD 2730
150/ 2493-2518 120/ 2552-72 150/ 2606-31
150/ 2653-78 Her. 2495 Win. 2556
Ft. Riley 2606 40000 A
Comp. 911,000 gas 405#

J. E. TYRA

County **Kearny** State **Kansas**Sec. **24** (Blk. **24** (Sur. **38W** Map No.Operator **Kansas-Nebraska**Well No. **1** Farm **Adams**Elev. Location **C N L SW/4**

FIRST REPORT**0****2540** Ft. From **S** Line **SW****1320** Ft. From **W** Line Quarter1st. Report **MAY 2 1951**

Completion

Remarks

Spudding Date **4-19-51**Drlg. Data **Hugoton Pool****10" @ 800 drlg. 1700**

J. E. TYRA