

DRILLING WELL COMPLETION REPORT

Well No. 1 Farm Name Clara A. Stewart

Date completed May 20, 1948

Description All Sec. 29 - 24S - 30W

County Kearny, State Kansas

Initial production _____ bbls. Total depth 2624 feet

Initial volume 5,600,000 cu. ft. _____ lbs. rock pressure

Pipe Line Company _____

Gas Company _____

Remarks: _____

A. E. Ploran

W

Mr. Koontz
Accounting Dept.
Scouting Dept. 3
Geological Dept.
Pipe Line Dept.
Materials Dept.
Rental Dept.
Legal Dept.
Mr. Leo Meyer
Engineering Dept.
Lease Inventory
Mr. Leo Austin
File

Glenn J. Smith

LOCATION NOTICE

KANSAS


TULSA, OKLA., April 14, 1948, 19

KANSAS

KANSAS

WELL NO. 1 ON Clare A. Stewart FARM

WILL BE AS FOLLOWS:

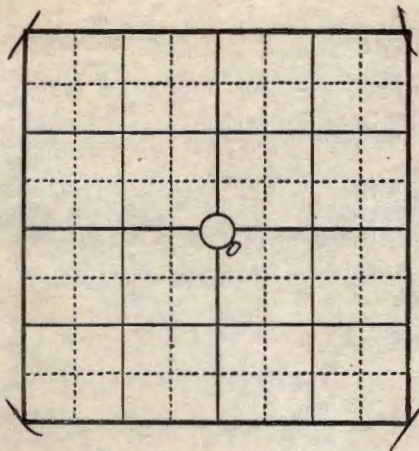

FEET FROM NORTH LINE

2540

FEET FROM EAST LINE

2540

FEET FROM SOUTH LINE

FEET FROM WEST LINE

IN 411 SEC. 29 TWP. 24N RANGE 30EKearney COUNTY, STATE OF KansasREMARKS: Lloyd Snyder- District Supt.

SIGNED

A. R. Flores

COPIES TO

MR. KOONTZ

DISTRICT SUPT.

ACCOUNTING DEPT.

SCOUTING DEPT.

GEOLOGICAL DEPT.

PIPE LINE DEPT.

MATERIALS DEPT.

RENTAL DEPT.

LEGAL DEPT.

TAX DEPT.

ENGINEERING DEPT.

LEASE INVENTORY

CLAIM DEPT.

FILE

Land Dept Map
End

Card
B. B.