


Section 35 Township 24 Range 38W

Well No. #1 H A Smalley ~~new~~ "A"

Company Mid-Continent Pet.
Hugoton Pool

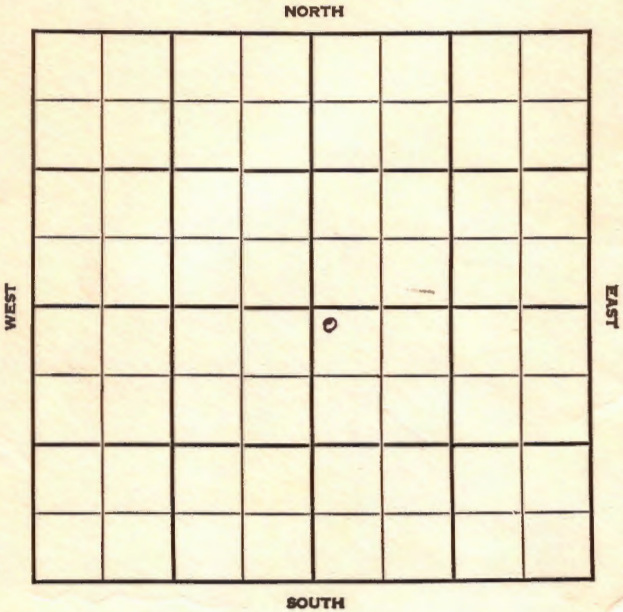

Sec. 35 Twp. 24 R. 38W

Well No. #1 H. A. Smalley "B" Farm

Mid-Continent Petroleum **75%** Company


Hugoton **Glenn Smith.....25%**

100 Ft. from N. Line

 Ft. from S. Line

 Ft. from E. Line

100 Ft. from W. Line

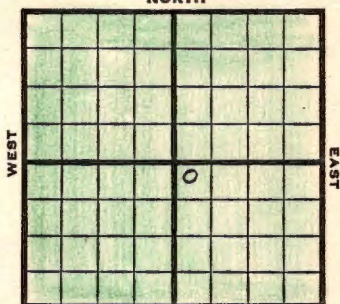

NW SE

Noble Drlg. Corp. contract

1948 **Est. Elev. 3245** **REPORT**

2675' test

4/14	Location	
4/23	MIT Spud 4-24-48	(P.R)
4/27	Drilling 1975' 8-5/8" - 663' w/350Tel)	
4/28	Drilling 2472'	
4/29	Will run Schl. to determine where to set pipe.	
	T.D. 2663'	(P.R)
4/30	5 1/2" set 2661' w/375 sacks.	"
5/3	WOC	
5/4	WOC	
5/5	Drlg. cement. TD 2666'	"
5/6	Acid. w/500 gal. Sli. show gas.	"
5/7	Acid. w/3000 gal.	
	Only slight show gas.	
	Will set plug above & perf. Harrington Crider & Winfield.	
5/10	Perf. 2492'-2580' 204 shots	
	Acid. w/1000 gal.	
	Making 5 Million cu.ft. Saturday.	
	Acidized w/total 9000 gal.	
	Making 7 Million cu.ft. Monday.	
	Testing.	(P.R)
5/11	Showing over 7 million cu. ft. gas.	
	Water decreasing. Testing.	"
5/12	Well shut in to take 72 hr. final completion test.	"
5/13	SI for 72 hr. test.	"

OVER

1948

5/17 Completed 5-14-48
10,240,000 cu.ft. per day.
435# pressure

(P.R.)

5/19 5" @ 2666'
Perf.
Acid 9000
Gas 10,240,000
R. Pr. 430#
TD 2686'

COMPLETED

No Map
Map No. _____ Sec. 35 Twp. 24 R. 38W

Well No. 1 H. A. Smalley "A"

Mid-Continent Petroleum Company

CORRECTION

Contractor

NW SE

SECTION PLAT

100 Ft. from N. Line

_____ Ft. from S. Line

_____ Ft. from E. Line

100 Ft. from W. Line

		o	

Kearny County

Location _____

Rig up _____

Drilling and Remarks:

Reported

#1 H.A. Smalley "C"

RECORD

Cased _____ in., _____ ft.

Sand _____

Gas _____

Oil _____

Total Depth _____

PRODUCTION

1st 24 hrs. Nat. _____

1st 24 hrs. after shot _____

Gas _____ Cu. Ft.

Dry Hole _____

Abandoned _____

Date

APR 21 1948

19

S. J. LEWIS

Scout

Map No. _____ Sec. 35 Twp. 24 R. 38W

Well No. 1 H. A. Smalley "C"

Mid-Continent Petroleum Company

NW SE FIRST REPORT Contractor

100 Ft. from N. Line

_____ Ft. from S. Line

_____ Ft. from E. Line

100 Ft. from W. Line

Kearny County

SECTION PLAT

		o	

Location _____

Rig up _____

Drilling and Remarks:

RECORD

Cased _____ in., _____ ft.

Sand _____

Gas _____

Oil _____

Total Depth _____

PRODUCTION

1st 24 hrs. Nat. _____

1st 24 hrs. after shot _____

Gas _____ Cu. Ft.

Dry Hole _____

Abandoned _____

Date

APR 14 1948 19 _____ S. J. LEWIS Scout

Map No. _____ Sec. 35 Twp. 24 R. 38W

Well No. 1 H. A. Smalley "A"

Mid-Continent Pet. Company

COMPLETE

Contractor

NW SE


E1.3245-
SECTION PLAT

100 Ft. from N. Line

_____ Ft. from S. Line

_____ Ft. from E. Line

100 Ft. from W. Line

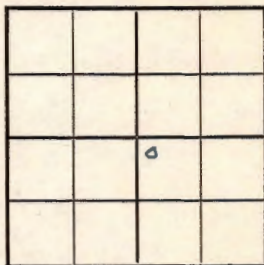

Kearny County

Location _____

Rig up _____

Drilling and Remarks:

5' C2666

Prof.

9000 cu. ft.

10,240,000 gal

430 R/B

RECORD

Cased _____ in., _____ ft.

Sand _____

Gas _____

Oil _____

Total Depth 2686

PRODUCTION

1st 24 hrs. Nat. _____

1st 24 hrs. after shot _____

Gas _____ Cu. Ft.

Dry Hole _____

Abandoned _____

Date

MAY 19 1948

19

S. J. LEWIS

Scout