

DRILLING WELL COMPLETION REPORT

Well No. 1 Farm Name J. Turner Unit

Date completed Oct. 1, 1951

Description Sec. 28-24S-38W

County Kearny State Kansas

Initial production _____ bbls. Total depth 2650 feet

Initial volume 422,000 cu. ft. _____ lbs. rock pressure

M.C.P.C. Interest 39.99975%

Remarks: Operated by Kansas-Nebraska Natural Gas Co.

A. E. Pierce

W


Mr. McDowell
Accounting Dept. 3
Scouting Dept.
Geological Dept.
Pipe Line Dept.
Materials Dept.
Rental Dept.
Legal Dept.
Mr. Leo Meyer
Engineering Dept.
Lease Inventory
Income Tax Dept.
File

LOCATION NOTICE

TULSA, OKLA., April 26, 1951, 19____

WELL NO. 1 ON J. Turner Unit FARM

WILL BE AS FOLLOWS:

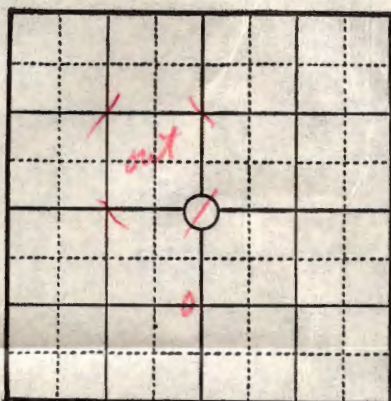

____ FEET FROM NORTH LINE

____ FEET FROM EAST LINE

1320 FEET FROM SOUTH LINE

2540 FEET FROM WEST LINE

600 Acres

IN SEC. 28 TWP. 24S RANGE 38W

Kearny COUNTY, STATE OF Kansas

REMARKS: Operated by Kansas-Nebraska Natural Gas Co.

M. C. P. C. 39.999754

Olenn J. Smith 13.333254

SIGNED A. E. Pioras

COPIES TO

R. W. McDOWELL
DISTRICT SUPT.
ACCOUNTING DEPT.
✓ SCOUTING DEPT.
GEOLOGICAL DEPT.
PIPE LINE DEPT.
MATERIALS DEPT.
RENTAL DEPT.
LEGAL DEPT.
LEO MEYER
INCOME TAX DEPT.
ENGINEERING DEPT.
LEASE INVENTORY
CLAIM DEPT.
J. W. BASORE
FILE

*Card Typed 10/11/51
mm*