

DRILLING WELL COMPLETION REPORT

Well No. 1 Farm Name H. A. Smalley "A"
Date completed May 14, 1948
Description All Section 35 - 24S - 38W
County Kearny, State Kansas
Initial production _____ bbls. Total depth 2686 feet
Initial volume 10,240,000 cu. ft. _____ lbs. rock pressure
Pipe Line Company _____
Gas Company _____
Remarks: _____

A. E. Pierce

Mr. Koontz McDowell
Accounting Dept.
✓ Scouting Dept.
Geological Dept.
Pipe Line Dept.
Materials Dept.
Inventory Comptroller
Rental Dept.
Legal Dept.
Tax Dept.
Engineering Dept.
Lease Inventory
File

Lee Austin
Glenn Smith

LOCATION NOTICE


TULSA, OKLA., April 21, 48, 19

KANSAS

WELL NO. 1 ON H. A. Smalley "A" FARM

KANSAS

WILL BE AS FOLLOWS:

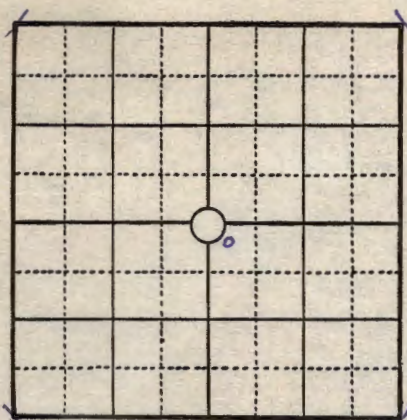

FEET FROM NORTH LINE
2540
 FEET FROM EAST LINE
2540
 FEET FROM SOUTH LINE
 FEET FROM WEST LINE

IN 111 SEC. 35 TWP. 24S RANGE 30W
Kearny COUNTY, STATE OF Kansas

REMARKS: Lloyd Snyder - District SuperintendentA. E. Johnson - ForemanM. C. F. C. - 75% - OperatorO. J. Smith - 25%

SIGNED

A. E. Pierce

COPIES TO

MR. KOONTZ

DISTRICT SUPT.

ACCOUNTING DEPT.

☒ SCOUTING DEPT.

GEOLOGICAL DEPT.

PIPE LINE DEPT.

MATERIALS DEPT.

RENTAL DEPT.

LEGAL DEPT.

TAX DEPT.

ENGINEERING DEPT.

LEASE INVENTORY

CLAIM DEPT.

FILE

W
 Card
 B.B.
 Map
 46