


Section 28 Township 24 Range 38WWell No. #1 TurnerCompany Kansas-Nebraska & Mid-Continent

NORTH

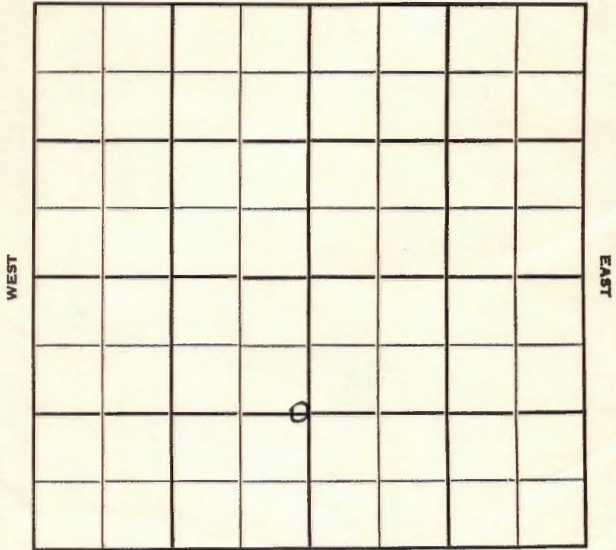

SOUTH

1951

9/14 Comp. for a deliverability test
of 422,000 CFGPD. (L R)

9/12 Spud 4-26-51
Gas Well TD 2650
10" @ 402 7" @ 2644
TD 2650
Her. 2404 Win 2459 Ft. Riley
2521
168/2404-32 108/2459-77
114/2521-40 192/2560-92
40,500 A Comp. 422,000 gas.

COMPLETED

County	Kearny		State	Kansas	
Sec.	28	(Blk. Twp.)	24	(Sur. Rge.)	38W Map No.
Operator	Kansas-Nebraska & Mid-Continent				
Well No.	1	Farm	Turner		
Elev.	3192	Location	C E L E $\frac{1}{2}$ SW		

1320 Ft. From S Line SW
2540 Ft. From W Line Quarter

1st. Report

Completion SEP 12 1951

Remarks	Hugoton Pool
---------	--------------

Spudding Date 4-26-51

Drilg. Data Gas well TD 2650


10" @ 402 7" @ 2644 TD 2650

Her. 2404 Win. 2459 Ft. Riley 2521

168/ 2404-32 108/ 2459-77 114/ 2521-40

192/ 2560-92 40500 A Comp. 422,000 gas

County **Kearny** State **Kansas**
 Sec. **28** (Blk.) **24** (Sur.) **38W** Map No.
 Operator **Kansas - Nebraska & Mid-Continent**
 Well No. **1** Farm **Turner**
 Elev. Location **C E L E $\frac{1}{2}$ SW**

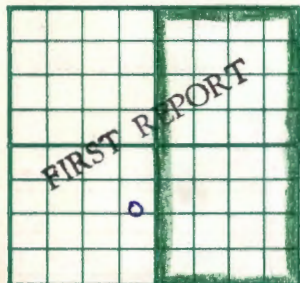

1320 Ft. From **S** Line **SW**
2540 Ft. From **W** Line Quarter
 Ist. Report **MAY 1 6 1951**
 Completion
 Remarks

Spudding Date **4-26-51**

Drlg. Data **Hugoton Pool**

10" @ 402 7" @ 2644 RTD 2650