

Kearny


KANSAS

DX 78-1

Section 1 Township 24 Range 38W

Well No. #1 Martin Gas Unit "C "

Company Stanolind

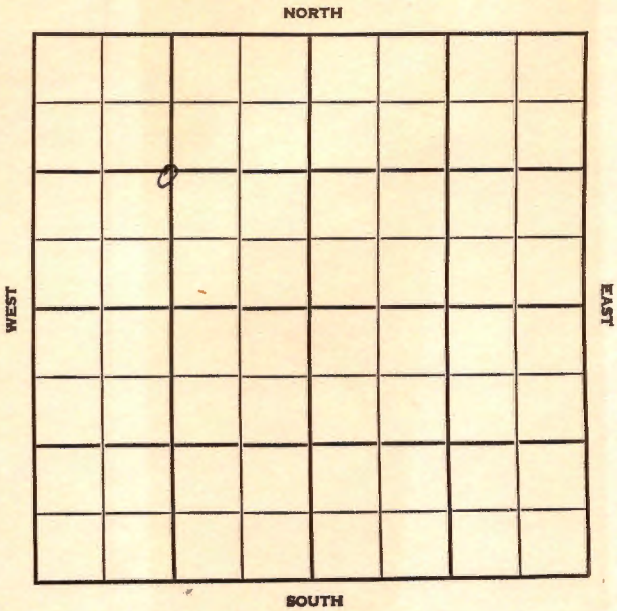

Kearny

KANSAS

SEC.	TWP.	R.
1	24	38W

WELL NO.

#1 Martin Gas Unit "C"

FARM

COMPANY

Stanolind

CONTRACTOR

Barbour

Hugoton Pool

NORTH

1320


Ft. from N. Line

Ft. from S. Line

Ft. from E. Line

1320

Ft. from W. Line

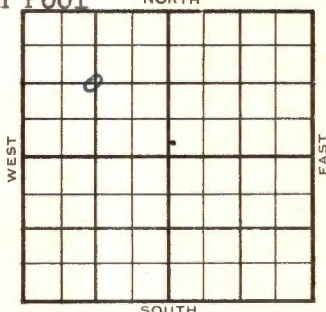

C NW/4

	ELEVATION	REPORT
1954	3319'	

11/11

Location

1955
1/5

Spud 11-18-54 - W Gas Well

TD 2751'

8-5/8" @ 815'

Her. 2577', Win. 2631', Tow 2692',
Ft. Filey 2720'

TD 2751'

5" @ 2720'

Kri. 2609'

6000A A-frac

370,000 cfg, 50 gswph

SP 2711

60/2698-2703, 12/2690-92, 24/2678-82,
2500A


Sd-frac

767,000 cfg, 72/2631-43, 36/2650-56,
96/2580-96, 12/2600-02, 12/2607-09,

36/2611-17, SP 2668', 11000A

Comp. 4,630,000 cfgpd, 360#

COMPLETED

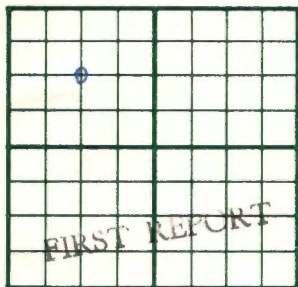County **Kearny** State **Kansas**Sec. **1** (Blk.) **24** (Sur. Rge.) **38W** Map No.Operator **Stanolind**Well No. **1** Farm **Martin Gas Unit "C"**Elev. Location **C NW/4****1320** Ft. From **E** Line **NW****1320** Ft. From **W** Line Quarter1st. Report **NOV 10 1954**

Completion

Remarks


Barbour - Contr.

Spudding Date

Drlg. Data **Hugoton Pool****Location**

FABEN GILSTRAP

County Kearny State Kansas
 Sec. 1 (Blk.) 24 (Sur.) 38W Map No.
 Operator Stanolind
 Well No. 1 Farm Martin Gas Unit "C"
 Elev. 3319 Location C NW¹/₄

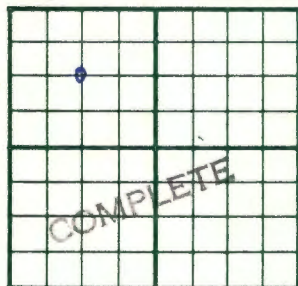

1320 Ft. From N Line NW
1320 Ft. From W Line Quarter
 1st. Report
 Completion JAN 5 1955
 Remarks Hugoton Pool
Barbour - Contr.
 Spudding Date 11-18-54

Drlg. Data Gas well TD 2751
8 5/8" @ 815 Her. 2577 Win. 2631
Tow. 2692 Ft. Riley 2720 TD 2751
5" @ 2720 Kri. 2609 6000 A A-frac
370,000 cfg 50 gswph SP 2711
60/ 2698-2703 12/ 2690-92 24/ 2678-82
2500 A sd-frac 767,000 cfg 72/ 2631-43
36/ 2650-56 96/ 2580-96 12/ 2600-02
12/ 2607-09 36/ 2611-17 SP 2668
11000 A Comp. 4,630,000 cfgpd 360#

FABEN GILSTRA