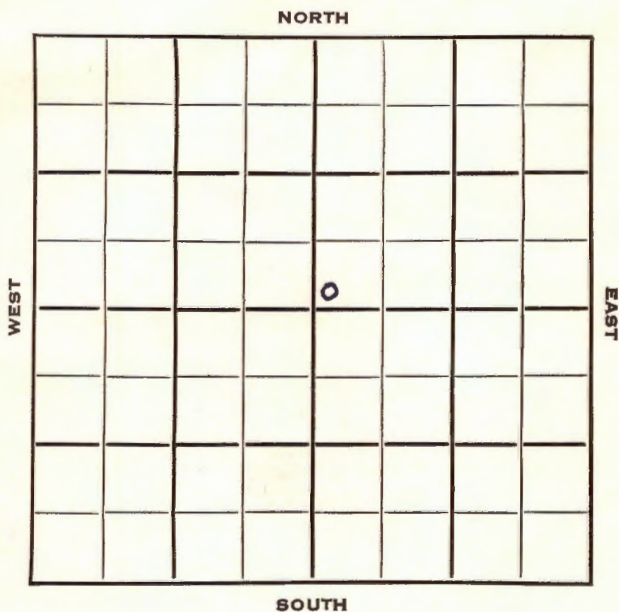


Section 2 Township 24 Range 38^WWell No. #1 VickersCompany W. E. Bakke

FORM 252-11
HOT FILE

Kearny

KANSAS ✓

Sec. 2 Twp. 24 R. 38 W

Well No. # 1 Vickers Farm

W. E. Bakke Company

Contractor


Ft. from N. Line

150 Ft. from S. Line

Ft. from E. Line

150 Ft. from W. Line

SW NE

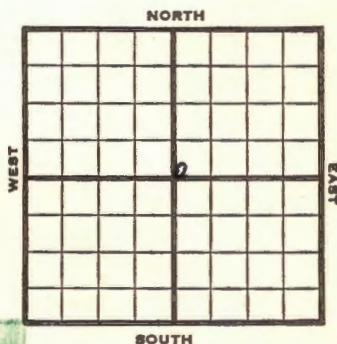

1953

Elev. 3312' REPORT

8/19

Spud 8-14-53
10" @ 289 WOC

8/26

RTD 2565
5" @ 2557'

9/2

DD
Her. Kr. 2560', Win 2614'
CO 2685'

9/9

Spud 8-14-53 Gas well TD 2748
10" @ 289 **Her. 2560 Win. 2614**
TD 2565 5" @ 2557 CO to 2685
DD 2748 **Ft. Riley 2684'** frac.
Comp. 11,100,000 gas.

COMPLETED

County Kearny State KansasSec. 2 (Blk.
Twp.) 24 (Sur.
Rge.) 38W Map No.Operator W. E. BakkeWell No. 1 Farm VickersElev. 3312 Location SW NE

150 Ft. From S Line NE150 Ft. From W Line Quarter

1st. Report

Completion SEP 9 1953

Remarks

Spudding Date 8-14-53Drilg. Data Gas well TD 274810" @ 289 Her. 2560 Win. 2614TD 2565 5" @ 2557 CO to 2685DD 2748 Ft. Riley 2684 fracComp. 11,100,000 gas