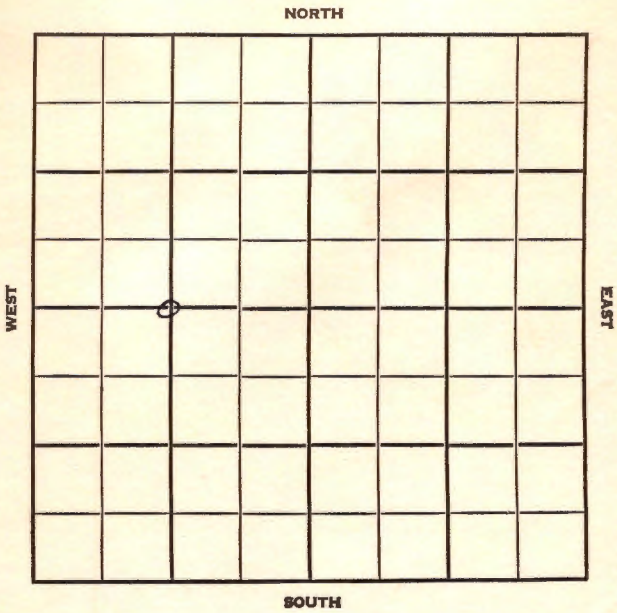


Section 12 Township 24 Range 38WWell No. #2 MilesCompany Kansas-Nebraska

Kearny KANSAS

SEC.	TWP.	R.
12	24	38W

WELL NO.

2 Miles

FARM

COMPANY

Kansas-Nebraska

CONTRACTOR

Honaker

Hugoton Pool

Ft. from N. Line

2490


Ft. from S. Line

Ft. from E. Line

1320

Ft. from W. Line

C W/2 Sec.

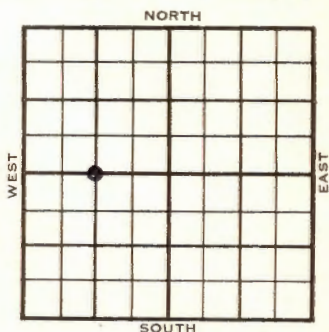

1955	ELEVATION	REPORT
	3298'	

3/2

Spud 2-22-55
10" @ 297'
TD 2770'

4/27

Spud 2-22-55 - Gas Well
TD 2770'
10" @ 297'
TD 2770'
7" @ 2762'
CO, 132/2554-76, 120/2606-26,
2,800,000 cfg, frac 19,935,000 cfg
3000A
Comp. 19,935,000. c f g p d

COMPLETED


County Kearny State Kansas
 Sec. 12 (Blk. 24 (Sur. 38W Map No.
 (Twp.) (Rge.)
 Operator Kansas-Nebraska
 Well No. 2 Farm Miles
 Elev. 3298 Location C W $\frac{1}{2}$ Sec.



1320 Ft. From W Line Sec.
2490 Ft. From S Line Quarter
 1st. Report
 Completion APR 27 1955
 Remarks Hugoton Pool
Honaker Drlg. - Contr.
 Spudding Date 2-22-55

Drlg. Data Gas well TD 2770
10" @ 297 TD 2770 7" @ 2762
CO 132/ 2554-76 120/ 2606-26
2,800,000 cfg frac 19,935,000 cfg
3000 A Comp. 19,935,000 cfgpd

FABEN GILSTRAP

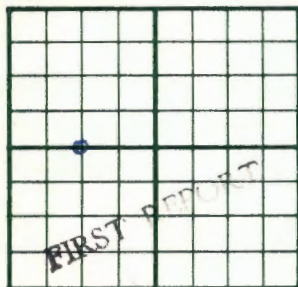County **Kearny** State **Kansas**Sec. **12** (Blk.) **24** (Sur.) **38W** Map No.Operator **Kansas-Nebraska**Well No. **2** Farm **Miles**Elev. Location **C W $\frac{1}{2}$ Sec.****1320** Ft. From **W** Line **Sec.****2490** Ft. From **S** Line Quarter1st. Report **MAR 2 1955**

Completion

Remarks

Honaker - Contr.Spudding Date **2-22-55**Drlg. Data **Hugoton Pool****10" @ 297 TD 2770**

FABEN GILSTRAP