

Section 15 Township 24 Range 38WWell No. #1 WiattCompany W. B. Osborne

NORTH

				0			

WEST

EAST

SOUTH

HOT FILE

Nearby

KANSAS

Sec. 15 Twp. 24 R. 38W

Well No. #1 Wiatt Farm

W. B. Osborne Company

Contractor


150' Ft. from N. Line

_____ Ft. from S. Line

_____ Ft. from E. Line

150' Ft. from W. Line

NW SE

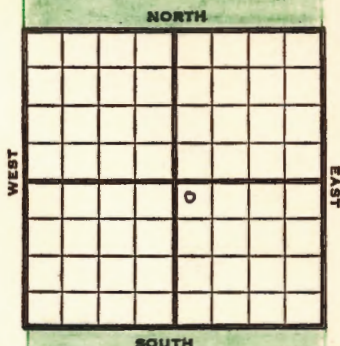

1951 **Elev. 3292'** REPORT

9/19 10" @ 340

7" @ 2515

RTD 2540

9/27 No report.

(L R)

11/21 Spud 8-15-51

Gas Well TD 2710

10" @ 340 7" @ 2515 TD 2710

Her. 2518 Kri, 2536

Win. 2574 Towanda 2644

Ft. Riley 2683 15500 A

Comp. 655,000 gas

COMPLETED

County **Kearny** State **Kans.**Sec. **15** (Blk. Twp.) **24** (Sur. Rge.) **38W** Map No.Operator **W. B. Osborne**Well No. **1** Farm **Wiatt**Elev. Location **NW SE**

150 Ft. From **N** Line **SE****150** Ft. From **W** Line **Quarter**1st. Report **SEP 19 1951**

Completion

Remarks

**MCPC has N $\frac{1}{2}$ & SW of 22
and S $\frac{1}{2}$ NE of 21**Spudding Date **8-15-51**

Drilg. Data

10" C 340 7" C 2515 RTD 2540

County Kearny State KansasSec. 15 (Blk. Twp.) 24 (Sur. Rge.) 38W Map No.Operator W. B. OsborneWell No. 1 Farm WiattElev. 3292 Location NW SE

150 Ft. From N Line SE150 Ft. From W Line Quarter

1st. Report

Completion NOV 21 1951

Remarks

Spudding Date 8-15-51Drlg. Data Gas well TD 271010" @ 340 7" @ 2515 TD 2710Her. 2518 Kri. 2536 Win. 2574Wowanda 2644 Ft. Riley 2683 15500 AComp. 655,000 gas

J. E. TYRA