


Section 16 Township 24 Range 38 W

Well No. # 1 Jackson

Company Northern Pump

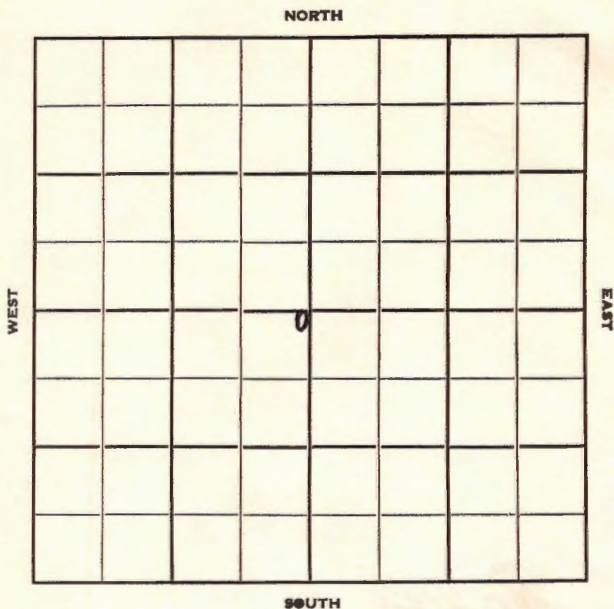

FORM 252-B
HOT FILE

Kearny

KANSAS ✓

Sec. 16 Twp. 24 R. 38 W

Well No. # 1 Jackson Farm

Northern Pump Company


Hugoton Pool Contractor

190 Ft. from N. Line

 Ft. from S. Line

190 Ft. from E. Line

 Ft. from W. Line

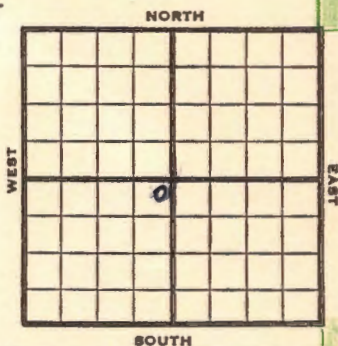

NE SW

MCPC has acreage near.

1953 **Elev. 3287'** REPORT

6/24 Spud 6-17-53
10" @ 295 WOC

7/1 RTD 2687' 7" @ 2680
Schl tops: **Her 2497' Kr 2528'**
Win 2571' Tow 2637' Ft Riley 2674'

7/8 CO 2679' 6/2660 6/2612 Sq.


7/22 DD 2687 3000 dol PB 2656
84/ 2632-46 132/ 2570-92 156/
2516-42 dol-frac.
CO 2687'

7/29 No report

8/5 Spud 6-17-53 Gas well TD 2687
10" @ 295 **Her 2497 Kri 2528**
Win 2571 Tow. 2637 Ft. Riley 2674
TD 2687 7" @ 2680 CO to 2679
6/2660 6/2612 DD 2687 3000 dol
frac. PB 2656 84/2632-46
132/2570-92 156/2516-42 dol-frac
CO to 2687
Comp. 5,803,000 gas 386#

COMPLETED

J. G. McGEHEE

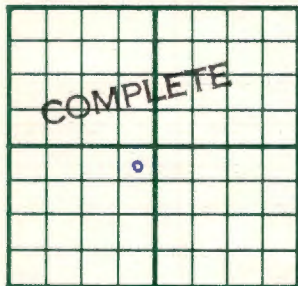County Kearny State KansasSec. 16 (Blk.) 24 (Sur.) 38W Map No.Operator Northern PumpWell No. 1 Farm JacksonElev. 3287 Location NE SW190 Ft. From N Line SW190 Ft. From E Line Quarter

1st. Report

Completion AUG 5 1953Remarks Hugoton PoolSpudding Date 6-17-53Drlg. Data Gas well TD 268710" @ 295 Her. 2497 Kri. 2528Win. 2571 Tow. 2637 Ft. Riley 2674TD 2687 7" @ 2680 CO to 26796/ 2660 6/ 2612 DD 2687 3000 dol fracPB 2656 84/ 2632-46 132/ 2570-92156/ 2516-42 dol-frac CO to 2687Comp. 5,803,000 gas 386#