

Hamilton

KANSAS

2

24S

39W

SECTION _____ TOWNSHIP _____ RANGE _____

#2 Thomeczek

WELL NO. _____

Kans.- Nebr.


COMPANY _____

NORTH

C SE $\frac{1}{4}$

WEST

EAST

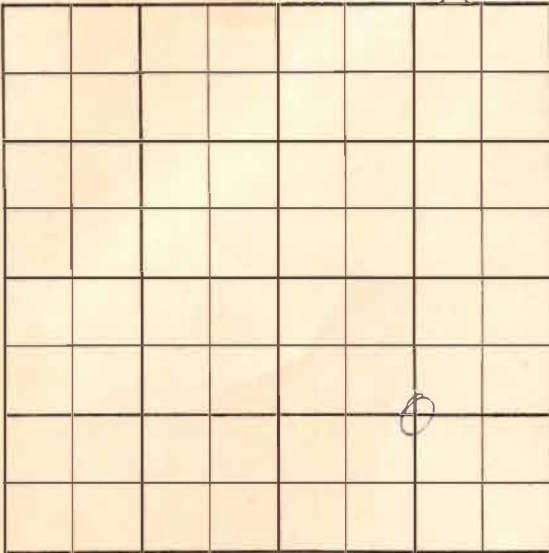

SOUTH

二

ABANDONED

NOV 13 '57

CC

USE

20

55

TW

8" @ 314 w/200, Dr1g.

Oct 23 5-4 " 2239

150 WDC

Log Kes 2424

2435 Win 2474

16/2426-30 33

2434-42 64/2474-90 559

max f = 28x4 of Ld. TSTm

100722 ST 10170 ST ϵ r Δ 38x30

gas TSTM

D 6 A

~~A~~CO. ~~Hamilton~~ ELEV. _____SEC. ~~2~~ TWP. ~~24~~ RGE. ~~39W~~COMPANY ~~Kans-Nebr~~ NO. ~~2~~

FIRST REPORT	
0	2
5	0

FARM ThomeczekLOC. C SE/4

GEOL. _____

CONTR. Fees Drlg. ToolsPOOL HugotonSPUD 9-28-57

8" @ 314, w/200, Drlg.

CO.

TSE.

NO.

SEC.

TWP.

RGE.