

Hamilton

KANSAS

11

24

39W

SECTION _____ TOWNSHIP _____ RANGE _____

#1 Tebo

WELL NO. _____


COMPANY Kansas-Nebr. & Sun

NORTH

100' N of C E/2

WEST

EAST

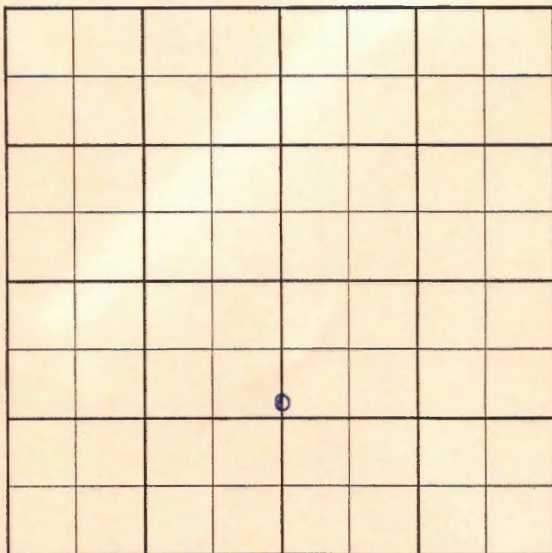

SOUTH

K-34

5-513-A

CORRECTION

CO. Hamilton ELEV. 3248

SEC. 11 TWP. 24 RGE 39W

COMPANY Kansas-Nebr. NO. 1

8 Sun

FARM Tebo

LOC. 100' N of C E/2

NOV 27 57

CO.

COMPLETE

LSE.

GEOL.

CONTR. Fees

POOL Hugoton

SPUD 9-22-57

8" @ 336/200 drlg.

OCT 2 57

NO.

SEC.

TWP.

RGE.

log
Her 2429
Cind 2442
win 2484
u Fort 2542
L " 2578

TD 2626

56" 2617/450 WOC

OCT 9 57 32/2552 -60 $\uparrow$ NS

SQD 56/2438 -52 72/2484-

2502 Frac 8x4 ga 38.8 mcf

tsq OCT 16 57 OCT 23 57 OCT 30 57 NOV 6 57

Op Fl 0 1.600 MCF N Pressure
w. inf

TD 2622

CO. Hamilton ELEV. _____SEC. 11 TWP. 24 RGE. 39WCOMPANY Kansas-Nebr. NO. 1

SEP 25 1957

FIRST REPORT

FARM TeboLOC. 100' N of C E/2

GEOL. _____

CONTR. FeesPOOL HugotonSPUD 9-22-578" @ 336/200 drlg.

CO.

LSE.

NO.

SEC.

TWP.

RGE.