


Hamilton

KANSAS

SECTION 13 TOWNSHIP 24 RANGE 39W

WELL NO. #1 Monnich

COMPANY Kans.-Nebraska

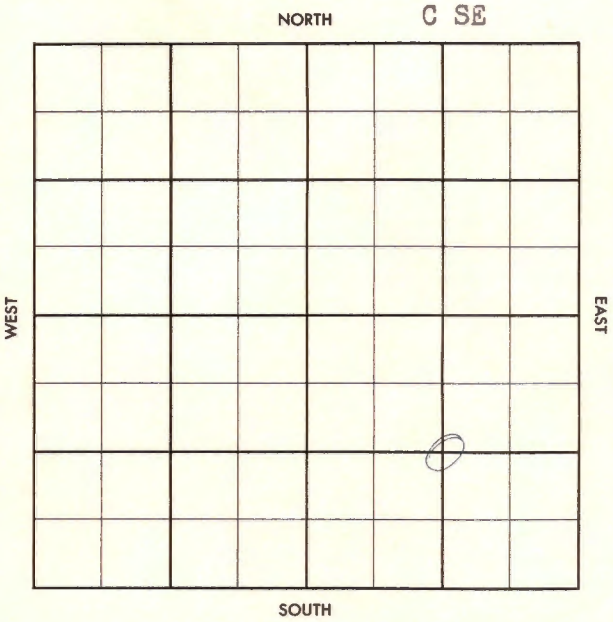

County Hamilton Elev. 3216
 Sec. 13 Twp. 24 Rge. 39W
 Company Kans. - Nebraska
 Farm Name Monnich No. 1

TOPS	DEPTH	LOG	DATUM	Loc. in Sec.
Ank <u>HCR</u>		<u>2388</u>		<u>C SE</u>
Tp. <u>WDR</u>		<u>2434</u>		
H. <u>FRY</u>		<u>2446</u>		
Tr.				
Dg.				
Bl.				
L.				
N.C.				Geol.
B.K.C.				Contr.
Ce.				Fees Tools
C.				
M.				Pool
M.				
K.				Huroton
Mz.				
Mo.				
V.				
S.				
S.				
A.				
R.				
Pe.				
G.				
T.D.	<u>2533</u>			

COMPLETE
 MAY 15 '77

Date Comm.

MTRT MAY 1 57 4 - 23 - 57 8 5/8 157
 1175 5 1/2 2529/200 MAY 11 57
 SO 40/2494 - 2504 1 92 1 1/2
 MUI CFA PF 81/2388 - 2410
 24/2434 - 50 FRA 92 2.750
 MCFG (wet) 92 2.225 MCFG
 P.D. MAY 15 57 complete 92 2.225
 MCFG d.

County Hamilton

Elev. _____

Sec. 13Twp. 24Rge. 39WCompany Kans.-NebraskaFarm Name MonnichNo. 1

TOPS

DEPTH

LOG

DATUM

Loc. in Sec. _____

Anb. _____

Tp. _____

H. _____

Tr. _____

Dg. _____

Bl. _____

L. _____

K.C. _____

B.K.C. _____

Ce. _____

C. _____

M. _____

M. _____

K. _____

Mz. _____

Mq. _____

V. _____

S. _____

S. _____

A. _____

R. _____

P.E. _____

G. _____

T.D. _____

C SE

Geol. _____

Contr. _____

Fees Tools

Pool

Hugoton

FIRST REPORT

APR 24 57

Date Comm. _____

MIRT

34